


WELL PLUGGING RECORD

All Information Completely  
Required Affidavit  
For Deliver Report to:  
Conservation Division  
State Corporation Commission  
211 No. Broadway  
Wichita, Kansas

Rooks County. Sec. 14 Twp. 7S Rge. 20W (NE) (W)  
Location as "NE/CNW/SW" or footage from lines SE NE SE  
Lease Owner Leben Drilling, Inc. Etal  
Lease Name Cooper Well No. 1  
Office Address P. O. Box 486, Great Bend, Kansas  
Character of Well (completed as Oil, Gas or Dry Hole) Dry Hole  
Date well completed 7-23-63 19  
Application for plugging filed 7-23-63 19  
Application for plugging approved 7-23-63 19  
Plugging commenced 7-23-63 19  
Plugging completed 7-23-63 19  
Reason for abandonment of well or producing formation Dry Hole

NORTH

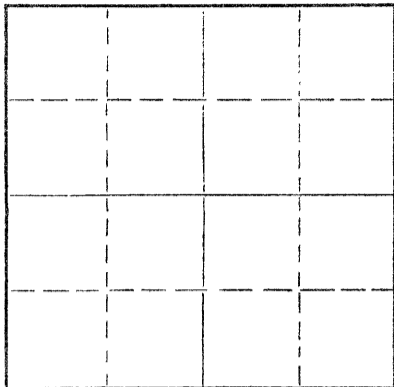

Locate well correctly on above  
Section Plat

If a producing well is abandoned, date of last production \_\_\_\_\_ 19\_\_\_\_  
Was permission obtained from the Conservation Division or its agents before plugging was com-  
menced? yes

Name of Conservation Agent who supervised plugging of this well Eldon Petty, Hays, Kansas  
Producing formation \_\_\_\_\_ Depth to top \_\_\_\_\_ Bottom \_\_\_\_\_ Total Depth of Well 3557 Feet  
Show depth and thickness of all water, oil and gas formations.

OIL, GAS OR WATER RECORDS

CASING RECORD

FORMATION	CONTENT	FROM	TO	SIZE	PUT IN	PULLED OUT
				8 5/8"	207'	none

Describe in detail the manner in which the well was plugged, indicating where the mud fluid was placed and the method or methods used in introducing it into the hole. If cement or other plugs were used, state the character of same and depth placed, from \_\_\_\_\_ feet to \_\_\_\_\_ feet for each plug set.

Plugged with:

20 sacks cement, plug 500'  
20 sacks cement, plug 200'  
1/2 sack hulls and 10 sacks cement, plug 35'

RECEIVED  
STATE CORPORATION COMMISSION  
JUL 29 1963  
JUL 29 1963  
CONSERVATION DIVISION  
Wichita, Kansas

(If additional description is necessary, use BACK of this sheet)

Name of Plugging Contractor Leben Drilling, Inc.  
Address P. O. Box 486, Great Bend, Kansas

STATE OF KANSAS, COUNTY OF BARTON, ss.  
Leslie Kite

(employee of owner) or (owner or operator) of the above-described well, being first duly sworn on oath, says: That I have knowledge of the facts, statements, and matters herein contained and the log of the above-described well as filed and that the same are true and correct. So help me God.

(Signature) Leslie Kite  
P. O. Box 486, Great Bend, Kansas  
(Address)

SUBSCRIBED AND SWORN TO before me this 26th day of July, 1963

My commission expires April 1, 1967

Ulanda Nichols  
Ulanda Nichols Notary Public.

