


15-065-00239-00-00

STATE OF KANSAS  
STATE CORPORATION COMMISSION

WELL PLUGGING RECORD

Give All Information Completely  
Make Required Affidavit  
Mail or Deliver Report to:  
Conservation Division  
State Corporation Commission  
800 Biting Building  
Wichita, Kansas

Graham County, Sec 8 Twp 7 Rge 22 (X) W. (W)

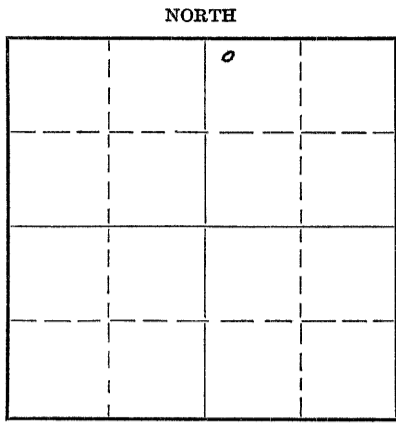

Locate well correctly on above Section Plat

Location as "NE/CNW 1/4 SW 1/4" or footage from lines NW NW NE  
Lease Owner Deep Rock Oil Corporation  
Lease Name Smika Well No. 1  
Office Address Box #1051, Tulsa, Oklahoma  
Character of Well (completed as Oil, Gas or Dry Hole) Dry Hole  
Date well completed September 22 19 51  
Application for plugging filed September 7 19 51  
Application for plugging approved 19  
Plugging commenced September 2 19 51  
Plugging completed September 3 19 51  
Reason for abandonment of well or producing formation

If a producing well is abandoned, date of last production 19  
Was permission obtained from the Conservation Division or its agents before plugging was commenced? Yes, permission obtained from Eldon Petty

Name of Conservation Agent who supervised plugging of this well Eldon Petty  
Producing formation Arbuckle Depth to top 3915' Bottom 3990' Total Depth of Well 3990' Feet  
Show depth and thickness of all water, oil and gas formations.

OIL, GAS OR WATER RECORDS

CASING RECORD

| Formation | Content | From | To | Size   | Put In | Pulled Out |
|-----------|---------|------|----|--------|--------|------------|
|           |         |      |    | 8-5/8" | 221'   | None       |
|           |         |      |    |        |        |            |
|           |         |      |    |        |        |            |
Describe in detail the manner in which the well was plugged, indicating where the mud fluid was placed and the method or methods used in introducing it into the hole. If cement or other plugs were used, state the character of same and depth placed, from feet to feet for each plug set.

Filled with heavy mud from 3990' to 245'. Set bridge at 245' and ran 40 sacks cement and 50# calcium chloride, filled to 140', put in heavy mud to 25', set plug, ran 10 sacks cement, filled to top of hole and into cellar.

RECEIVED  
STATE CORPORATION COMMISSION  
SEP 14 1951  
CONSERVATION DIVISION  
Wichita, Kansas

9-14-51

(If additional description is necessary, use BACK of this sheet)  
Correspondence regarding this well should be addressed to Deep Rock Oil Corporation  
Address Box #1146, Hutchinson, Kansas

STATE OF Kansas, COUNTY OF Reno, ss.  
Jack Smith (employee of owner) or (owner operator) of the above-described well,  
being first duly sworn on oath, says: That I have knowledge of the facts, statements, and matters herein contained and the log of the above-described well as filed and that the same are true and correct. So help me God.

(Signature) Jack Smith  
Box #1146, Hutchinson, Kansas  
(Address)

SUBSCRIBED AND SWORN to before me this 7th day of September, 1951  
C. E. Eagar  
Notary Public.

My commission expires August 2, 1953  
My commission expires

PLUGG.  
FILE SEC 8 T 7  
BOOK PAGE 108 LINE 30