

15-065-20085-00-00

STATE OF KANSAS
STATE CORPORATION COMMISSION


Form CP-4

Give All Information Completely
Make Required Affidavit
Mail or Deliver Report to:
Conservation Division
State Corporation Commission
212 No. Market
Wichita, Kansas

WELL PLUGGING RECORD

Graham County, Sec. 8 Twp. 7 Rge. ~~XXX~~ 22 (W)

NORTH

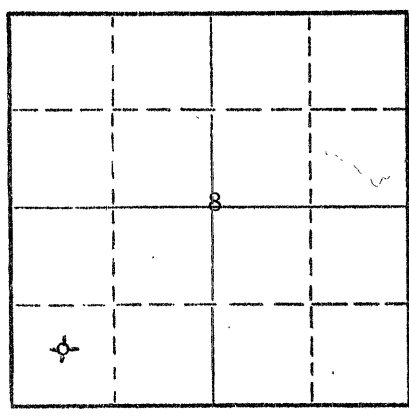

Locate well correctly on above Section Plat

Location as "NE/CNW%SW%" or footage from lines SW SW
Lease Owner M & O Oil Co.
Lease Name #1 Sperling Well No. 1
Office Address P.O. Box 791, Ft. Scott, Kansas
Character of Well (completed as Oil, Gas or Dry Hole) dry hole
Date well completed 9/16/67 19
Application for plugging filed 9/18/67 19
Application for plugging approved 9/16/67 19
Plugging commenced 9/16/67 19
Plugging completed 9/16/67 19
Reason for abandonment of well or producing formation dry hole

If a producing well is abandoned, date of last production 19
Was permission obtained from the Conservation Division or its agents before plugging was commenced? yes

Name of Conservation Agent who supervised plugging of this well W. L. Nichols
Producing formation _____ Depth to top _____ Bottom _____ Total Depth of Well 4000 Feet
Show depth and thickness of all water, oil and gas formations.

OIL, GAS OR WATER RECORDS

CASING RECORD

FORMATION	CONTENT	FROM	TO	SIZE	PUT IN	PULLED OUT
clay		0	135			
sand			145			
clay			165			
blue shale			197	8 5/8"	197'	-0-

Describe in detail the manner in which the well was plugged, indicating where the mud fluid was placed and the method or methods used in introducing it into the hole. If cement or other plugs were used, state the character of same and depth placed, from _____ feet to _____ feet for each plug set.

Bottom hole plug @ 1470' w/100 sx
Middle hole plug @ 240' w/20 sx 50-50 Posmix w/6% Gel
Top plug 170' circulate with water

RECEIVED
STATE CORPORATION COMMISSION

SEP 19 1967

CONSERVATION DIVISION
WICHITA, KANSAS

(If additional description is necessary, use BACK of this sheet)
Name of Plugging Contractor Vaughan Drilling, Inc. 9-19-67
Address 1618 Wichita Plaza Bldg., Wichita, Kansas

STATE OF KANSAS, COUNTY OF SEDGWICK, ss.
Donald D. Vaughan (employee of owner) or (owner or operator) of the above-described well, being first duly sworn on oath, says: That I have knowledge of the facts, statements, and matters herein contained and the log of the above-described well as filed and that the same are true and correct. So help me God.

(Signature) Donald D. Vaughan
1618 Wichita Plaza, Wichita, Ks.
(Address)

SUBSCRIBED AND SWORN TO before me this 18th day of September, 19 67

My commission expires 3/10/71
Carolyn Sinning
Carolyn Sinning Notary Public.



JOHN ANDERSON, Jr. Governor
 RICHARD C. BYRD Chairman
 ALVIN F. GRAUERHOLZ Commissioner
 HARRY G. WILES Commissioner
 RAYMOND B. HARVEY Secretary
 CHARLES C. McCARTER Gen. Counsel

RECEIVED State Corporation Commission
 CONSERVATION DIVISION
 (Oil, Gas and Water)
 500 Insurance Bldg. 212 N. Market
 WICHITA, KANSAS

OCT 16 1967
 10-16-67
 CONSERVATION DIVISION
 Wichita, Kansas

AUTHORIZATION

The undersigned, owner of the following described land, to
 wit: SW 1/4 of the SW 1/4 of Sec. 8 Twp. 7 Rge. 22 W
Graham County, Kansas; hereby requests
 that Well No. 1 located in GSW-SW of Sec. 8 Twp. 7
 Rge. 22 W be left open above the fresh water protecting
 From 1500' to 1150' and from 240' to 170' with clear water from 170'.
 bridge set at 1 feet, to be used as a fresh water
 well and I hereby authorize M & O Oil Company, Incorporated,
 well owner, to so complete the abandonment of said well.

Witnessed by J. N. Hamner Robert R. Spurling
 (Land Owner)

Dated at Tit. Scott, Kansas, this 3 day of
October, 1967

