


Give All Information Completely  
Make Required Affidavit  
Mail or Deliver Report to:  
Conservation Division  
State Corporation Commission  
211 No. Broadway  
Wichita, Kansas

WELL PLUGGING RECORD

NORTH

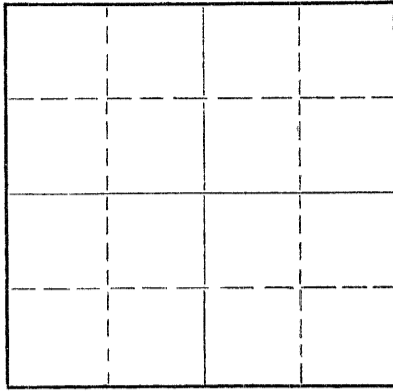

Locate well correctly on above  
Section Plat

Graham County, Sec. 7 Twp. 7S Rge. 22W (E) (W)

Location as "NE/CNW/SW" or footage from lines C SW SE

Lease Owner Imperial Oil of Kansas, Inc.

Lease Name Smika Well No. 1

Office Address 780 Fourth National Bldg., Wichita 2, Kansas

Character of Well (completed as Oil, Gas or Dry Hole) Dry Hole

Date well completed July 8 19 58

Application for plugging filed July 8 19 58

Application for plugging approved July 8 19 58

Plugging commenced July 8 19 58

Plugging completed July 8 19 58

Reason for abandonment of well or producing formation No commercial quantities of oil found.

If a producing well is abandoned, date of last production \_\_\_\_\_ 19 \_\_\_\_\_

Was permission obtained from the Conservation Division or its agents before plugging was commenced? Yes

Name of Conservation Agent who supervised plugging of this well A. D. Fabricius, Box 731, Hill City, Kansas

Producing formation \_\_\_\_\_ Depth to top \_\_\_\_\_ Bottom \_\_\_\_\_ Total Depth of Well 4010 Feet

Show depth and thickness of all water, oil and gas formations.

OIL, GAS OR WATER RECORDS

CASING RECORD

FORMATION	CONTENT	FROM	TO	SIZE	PUT IN	PULLED OUT
				8-5/8"	6-28-58	

Describe in detail the manner in which the well was plugged, indicating where the mud fluid was placed and the method or methods used in introducing it into the hole. If cement or other plugs were used, state the character of same and depth placed, from \_\_\_\_\_ feet to \_\_\_\_\_ feet for each plug set.

Set No. 1 plug at 550' with 25 sacks cement. Set No. 2 plug at 215' with 15 sacks cement. Set No. 3 plug at 40' with 10 sacks cement.

STATE CORPORATION COMMISSION  
CONSERVATION DIVISION  
JUL 22 1958

7-23-58

(If additional description is necessary, use BACK of this sheet)

Name of Plugging Contractor Imperial Oil of Kansas, Inc.  
Address 780 Fourth National Building, Wichita 2, Kansas

STATE OF KANSAS, COUNTY OF SEDGWICK, ss. Raymond L. Bacon (employee of owner or contractor) of the above-described well, being first duly sworn on oath, says: That I have knowledge of the facts, statements, and matters herein contained and the log of the above-described well as filed and that the same are true and correct. So help me God.

(Signature) By: Raymond L. Bacon V.P.

780 Fourth National Bldg., Wichita 2, Kansas (Address)

SUBSCRIBED AND SWORN TO before me this 22nd day of July, 19 58

Mona L. Latier  
Mona L. Latier Notary Public.

My commission expires July 7, 1962

PLUGGING  
FILE SEC 7 T 7 22W  
BOOK PAGE 116 LINE 15