


15-065-02616-00-00

Give All Information Completely
Make Required Affidavit
Mail or Deliver Report to:
Conservation Division
State Corporation Commission
211 No. Broadway
Wichita, Kansas

WELL PLUGGING RECORD

NORTH

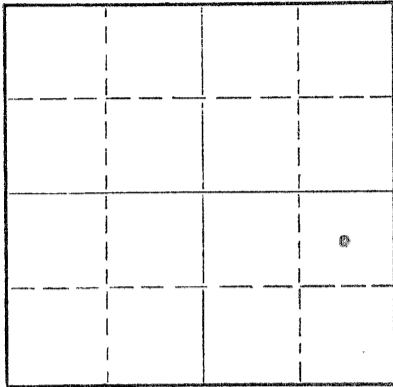

Locate well correctly on above
Section Plat

Graham County. Sec. 6 Twp. 7S Rge. 22 (E) W (W)
Location as "NE/CNW/SW" or footage from lines G NE SE
Lease Owner Alco Oil & Gas Corporation
Lease Name Smika Well No. 2
Office Address P. O. Box 520 Great Bend, Kansas
Character of Well (completed as Oil, Gas or Dry Hole) Dry Hole
Date well completed March 13, 19 63
Application for plugging filed March 13, 19 63
Application for plugging approved March 13, 19 63
Plugging commenced March 13, 19 63
Plugging completed March 13, 19 63
Reason for abandonment of well or producing formation Dry Hole

If a producing well is abandoned, date of last production _____ 19____
Was permission obtained from the Conservation Division or its agents before plugging was commenced? Yes

Name of Conservation Agent who supervised plugging of this well W. Nickels
Producing formation _____ Depth to top _____ Bottom _____ Total Depth of Well 3818 Feet
Show depth and thickness of all water, oil and gas formations.

OIL, GAS OR WATER RECORDS

CASING RECORD

FORMATION	CONTENT	FROM	TO	SIZE	PUT IN	PULLED OUT
		0	280'	8-5/8"	280'	None

Describe in detail the manner in which the well was plugged, indicating where the mud fluid was placed and the method or methods used in introducing it into the hole. If cement or other plugs were used, state the character of same and depth placed, from _____ feet to _____ feet for each plug set.

3818' to 550' - Heavy rotary mud
550' to 488' - 20 sacks cement and plug
488' to 275' - Heavy rotary mud
275' to 213' - Plug and 20 sacks cement
213' to 40' - Heavy rotary mud
40' to 6' - 1/2 sack hulls, plug & 10 sacks cement
6' to 0 - Cellar

RECEIVED
CORPORATION COMMISSION

MAR 20 1963

CONSERVATION DIVISION
Wichita, Kansas

3-20-63

(If additional description is necessary, use BACK of this sheet)
Name of Plugging Contractor PEEL BROTHERS, INC.
Address P. O. Box 359 Hoisington, Kansas

STATE OF KANSAS, COUNTY OF GRAHAM, ss.
Peel Brothers, Inc. (employee of owner) or (~~owner~~) of the above-described well, being first duly sworn on oath, says: That I have knowledge of the facts, and matters herein contained and the log of the above-described well as filed and that the same are true and correct. So help me God. PEEL BROTHERS, INC.

(Signature) Stendell E. Peel
P. O. Box 359 Hoisington, Kansas
(Address)

SUBSCRIBED AND SWORN to before me this 13 day of March, 19 63

My commission expires June 21, 1966

Ethel J. Williamson
Notary Public.

