


STATE OF KANSAS  
STATE CORPORATION COMMISSION

Give All Information Completely  
Make Required Affidavit  
Mail or Deliver Report to:  
Conservation Division  
State Corporation Commission  
211 No. Broadway  
Wichita, Kansas

15-065-00545-00-00  
WELL PLUGGING RECORD

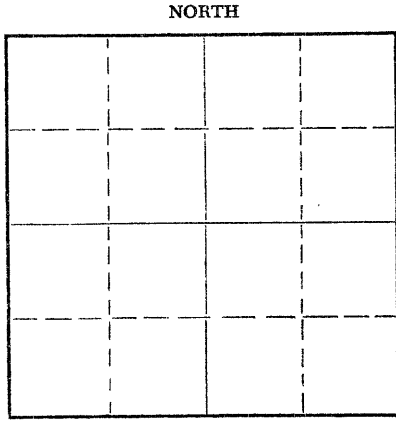

Locate well correctly on above  
Section Plat

GRAHAM County. Sec. 5 Twp. 7 Rge. 22 (R) W (W)  
Location as "NE/CNW/SW" or footage from lines C-SW, NW  
Lease Owner WOOD RIVER OIL & REFINING COMPANY, INC.  
Lease Name MULLER Well No. 1  
Office Address 321 WEST DOUGLAS, WICHITA, KANSAS  
Character of Well (completed as Oil, Gas or Dry Hole) DRY ROTARY  
Date well completed DECEMBER 15, 19 58  
Application for plugging filed DECEMBER 15, 19 58  
Application for plugging approved DECEMBER 15, 19 58  
Plugging commenced DECEMBER 15, 19 58  
Plugging completed DECEMBER 15, 19 58  
Reason for abandonment of well or producing formation NO PRODUCTIBLE ZONE

If a producing well is abandoned, date of last production 19\_\_\_\_  
Was permission obtained from the Conservation Division or its agents before plugging was commenced? YES

Name of Conservation Agent who supervised plugging of this well MR. A. D. FABRICIUS  
Producing formation \_\_\_\_\_ Depth to top \_\_\_\_\_ Bottom \_\_\_\_\_ Total Depth of Well 3810 Feet  
Show depth and thickness of all water, oil and gas formations.

OIL, GAS OR WATER RECORDS

CASING RECORD

FORMATION	CONTENT	FROM	TO	SIZE	PUT IN	PULLED OUT
				8 5/8"	224'	

Describe in detail the manner in which the well was plugged, indicating where the mud fluid was placed and the method or methods used in introducing it into the hole. If cement or other plugs were used, state the character of same and depth placed, from \_\_\_\_\_ feet to \_\_\_\_\_ feet for each plug set.

Gunned up pits forming heavy mud, started laying down drill pipe filling hole up to 600' with heavy mud, pushed wooden plug to 600', pumped 20 sax. cement through drill pipe on plug.  
Filled hole up to 220' with heavy mud, pushed wooden plug to 220', pumped 20 sax. cement through drill pipe on plug.  
Filled hole up to 40', pushed wooden plug to 40', capped with 10 sax. cement up to base of well cellar.  
Job complete @ 11:00 AM, 12-15-58

RECEIVED  
STATE CORPORATION COMMISSION  
DEC 18 1958  
CONSERVATION DIVISION  
Wichita, Kansas

12-18-58

(If additional description is necessary, use BACK of this sheet)  
Name of Plugging Contractor GARVEY DRILLING COMPANY  
Address ROUTE #2, GREAT BEND, KANSAS

STATE OF KANSAS, COUNTY OF BARTON, ss.  
VERNE A. MORRIS (owner or operator) of the above-described well, being first duly sworn on oath, says: That I have knowledge of the facts, statements, and matters herein contained and the log of the above-described well as filed and that the same are true and correct. So help me God.

(Signature) Verne A. Morris  
ROUTE #2, GREAT BEND, KANSAS  
(Address)

SUBSCRIBED AND SWORN TO before me this 16th day of DECEMBER 19 58

*[Signature]*  
Notary Public.

My commission expires July 11, 1960

PLUGGING  
FILE SEC. 5 T. 7 R. 22 W  
BOOK PAGE 5 LINE 17