

STATE OF KANSAS
STATE CORPORATION COMMISSION

Give All Information Completely
Make Required Affidavit
Mail or Deliver Report to:
Conservation Division
State Corporation Commission
212 North Market, Insurance Bldg.
Wichita, Kansas

WELL PLUGGING RECORD

Graham

County. Sec. 6 Twp. 7S Rge. (E) 22 (W)

Location as "NE/CNW/SW" or footage from lines C SE NE
Lease Owner Murfin Drilling Company
Lease Name Midrexter "B" Well No. 3
Office Address 617 Union Center, Wichita 2, Kansas
Character of Well (completed as Oil, Gas or Dry Hole) Dry Hole
Date well completed June 12 19 59
Application for plugging filed June 12 19 59
Application for plugging approved June 12 19 59
Plugging commenced June 12 19 59
Plugging completed June 12 19 59
Reason for abandonment of well or producing formation Dry Hole

If a producing well is abandoned, date of last production 19
Was permission obtained from the Conservation Division or its agents before plugging was commenced? yes

Name of Conservation Agent who supervised plugging of this well Mr. Fabricus
Producing formation Depth to top Bottom Total Depth of Well 3820 Feet
Show depth and thickness of all water, oil and gas formations.

OIL, GAS OR WATER RECORDS

CASING RECORD

FORMATION	CONTENT	FROM	TO	SIZE	PUT IN	PULLED OUT
				8 5/8"	212'	None

Describe in detail the manner in which the well was plugged, indicating where the mud fluid was placed and the method or methods used in introducing it into the hole. If cement or other plugs were used, state the character of same and depth placed, from feet to feet for each plug set.

Filled hole with mud to 550'. Set
1st plug at 500'. Displaced 20 sxs.
cement. Filled hole to 210'. Set
2nd plug. Displaced 20 sxs. cement.
Filled hole to 40'. Set 3rd plug.
Displaced 40 sxs. cement with 1/2 sxs.
hulls.

RECEIVED
STATE CORPORATION COMMISSION
JUL 29 1959
CONSERVATION DIVISION
Wichita, Kansas

Name of Plugging Contractor Murfin Drilling Company
Address 617 Union Center, Wichita 2, Kansas


STATE OF Kansas, COUNTY OF Sedgwick, ss.
W. R. Murfin (employee of owner) or (owner or operator) of the above-described well, being first duly sworn on oath, says: That I have knowledge of the facts, statements, and matters herein contained and the log of the above-described well as filed and that the same are true and correct. So help me God.

(Signature) W. R. Murfin
617 Union Center, Wichita 2, Kansas
(Address)


SUBSCRIBED AND SWORN TO before me this 28th day of July, 19 59

My commission expires March 23, 1960

Donna M. Matzek Notary Public.

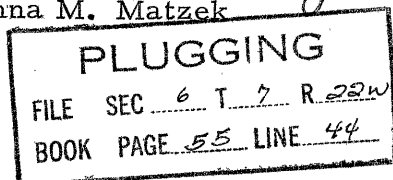

WELL LOG

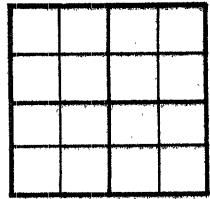01017
15-069-02017-00-00COMPANY Murfin Drilling Company
FARM Mildrexter "B" NO. 3SEC. 6 T. 7S R. 22W
LOC. C SE NETOTAL DEPTH 3820'
COMM. 6-6-59 COMP. 6-12-59
SHOT OR TREATED
CONTRACTOR Murfin Drilling Company
ISSUEDCOUNTY Graham
KANSASCASING
20 10
15 8 5/8" @ 212' w/165 sxs.
12 6
13 5ELEVATION 2368' K.B.
2363' G.L.
PRODUCTION D & A

FIGURES INDICATE BOTTOM OF FORMATIONS

212 Surface Hole
1340 Shale - Sand - Shells
1530 Shale - Sand - Pyrite
1755 Sand
2005 Red Bed - Shale
2040 Anhydrite
2415 Shale - Shells
3075 Shale - Lime Shells
3625 Lime - Shale
3820 Lime

GEOLOGICAL TOPS:

Heebner 3575
Toronto 3602
Lansing-Kansas City 3617
Base Kansas City 3807

DST #1 3638-51

Open 1 hour. Rec. 95' muddy salt
water. IF 0#. FF 0#. BHP 955#/20 min.

DST #2 3659-70

Open 1 hour. Rec. 25' mud with a
few spots of oil. IF 0#. FF 0#. BHP
120#/20 min.

DST #3 3719-66

Open 1 1/2 hours. Rec. 150' muddy
salt water with a few specks of oil.
IF 0#. FF 95#. BHP 910#/20 min.RECEIVED
STATE COMMISSION
JUL 29 1959
CONSL
W.
VISION

7-29-59

State of Kansas

County of Sedgwick

SS:

PLUGGING			
FILE	SEC	T.	R.
	6	7	22W
BOOK	PAGE	LINE	
	59	44	

I, W. R. Murfin of the Murfin Drilling Company
upon oath state that the above and foregoing is a true and correct copy of the log of the Mildrexter "B" #3 well.

Subscribed and sworn to before me this 28th day of July 19 59.

My Commission Expires: March 23, 1960

Donna M. Matzek
NOTARY PUBLIC
Donna M. Matzek