


15-065-00262-0000

STATE OF KANSAS
STATE CORPORATION COMMISSION

Give All Information Completely
Make Required Affidavit
Mail or Deliver Report to:
Conservation Division
State Corporation Commission
800 Bitting Building
Wichita, Kansas

WELL PLUGGING RECORD

NORTH

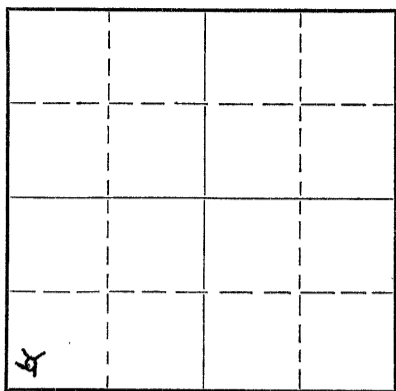

Locate well correctly on above
Section Plat

Graham County, Sec. 11 Twp. 7 Rge. 22 (E) W (W)
Location as "NE/CNW 1/4 SW 1/4" or footage from lines SW SW SW
Lease Owner DEEP ROCK OIL CORPORATION
Lease Name Brault Well No. 1
Office Address Box #1051, Tulsa, Oklahoma
Character of Well (completed as Oil, Gas or Dry Hole) Dry Hole
Date well completed October 11 19 51
Application for plugging filed October 10 19 51
Application for plugging approved October 15 19 51
Plugging commenced October 10 19 51
Plugging completed October 11 19 51
Reason for abandonment of well or producing formation

If a producing well is abandoned, date of last production 19
Was permission obtained from the Conservation Division or its agents before plugging was commenced? Yes

Name of Conservation Agent who supervised plugging of this well Mr. Eldon Petty
Producing formation Arbuckle Depth to top 3824' Bottom 3860' Total Depth of Well 3860' Feet
Show depth and thickness of all water, oil and gas formations.

OIL, GAS OR WATER RECORDS

CASING RECORD

Formation	Content	From	To	Size	Put In	Pulled Out
				8-5/8"	129'	None

Describe in detail the manner in which the well was plugged, indicating where the mud fluid was placed and the method or methods used in introducing it into the hole. If cement or other plugs were used, state the character of same and depth placed, from feet to feet for each plug set.

Filled with heavy mud from 3860' to 135'. Set bridge at 135' and ran 50 sacks regular bulk cement and 1 sack calcium chloride, filled to 55'. Filled with heavy mud to 40' and ran 10 sacks cement. Filled to top of hole and into cellar.

RECEIVED
CONSERVATION DIVISION
OCT 18 1951

(If additional description is necessary, use BACK of this sheet)

Correspondence regarding this well should be addressed to Deep Rock Oil Corporation
Address Box #1146, Hutchinson, Kansas

STATE OF Kansas, COUNTY OF Reno, ss. 10-19-51
Jack Smith (employee of owner) or (owner or operator) of the above-described well,
being first duly sworn on oath, says: That I have knowledge of the facts, statements, and matters herein contained and the log of the above-described well as filed and that the same are true and correct. So help me God.

(Signature) Jack Smith
Box #1146, Hutchinson, Kansas
(Address)

SUBSCRIBED AND SWORN TO before me this 18th day of Oct, 1951

C. E. Eagle
Notary Public.

My commission expires My Commission Expires August 2, 1953

23-3273-s 4-50-10M

PLUGGING
FILE SEC 11 T 7 R 26
BOOK PAGE 116 LINE 36