


STATE OF KANSAS
STATE CORPORATION COMMISSION

WELL PLUGGING RECORD

Give All Information Completely
Make Required Affidavit
Mail or Deliver Report to:
Conservation Division
State Corporation Commission
800 Bittling Building
Wichita, Kansas

Graham County. Sec. 30 Twp. 7 Rge. 24 (E) (W)
Location as "NE/CNW $\frac{1}{4}$ SW $\frac{1}{4}$ " or footage from lines SW-SW-SE
Lease Owner S. A. Berwick Drilling Company, Etal.
Lease Name Fox Well No. 1
Office Address P. O. Box 64, Great Bend, Kansas
Character of Well (completed as Oil, Gas or Dry Hole) Dry Hole
Date well completed November 25 19 53
Application for plugging filed November 25 19 53
Application for plugging approved November 25 19 53
Plugging commenced November 25 19 53
Plugging completed November 25 19 53
Reason for abandonment of well or producing formation Dry Hole

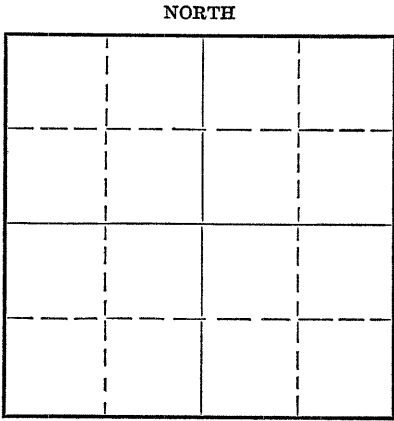

Locate well correctly on above
Section Plat

If a producing well is abandoned, date of last production None 19
Was permission obtained from the Conservation Division or its agents before plugging was commenced? Yes

Name of Conservation Agent who supervised plugging of this well Eldon Petty
Producing formation Depth to top Bottom Total Depth of Well 4360 Feet
Show depth and thickness of all water, oil and gas formations.

OIL, GAS OR WATER RECORDS

CASING RECORD

| Formation | Content | From | To | Size | Put In | Pulled Out |
|-----------|---------|------|----|------|--------|------------|
| | | | | | | |
| | | | | | | |
Describe in detail the manner in which the well was plugged, indicating where the mud fluid was placed and the method or methods used in introducing it into the hole. If cement or other plugs were used, state the character of same and depth placed, from 124 feet to 40 feet for each plug set.

Filled hole with heavy mud to 124 ft. Bridged hole 124 cemented with 15 sacks
Filled hole with heavy mud to 40 ft. Bridged hole 40 ft. and cemented to top with
9 sacks cement

(If additional description is necessary, use BACK of this sheet)

Correspondence regarding this well should be addressed to S. A. Berwick Drilling Company
Address P. O. Box 64, Great Bend, Kansas


STATE OF Kansas, COUNTY OF Barton, ss.
S. A. Berwick (employee of owner) or (owner or operator) of the above-described well,
being first duly sworn on oath, says: That I have knowledge of the facts, statements, and matters herein contained and the log of the above-described well as filed and that the same are true and correct. So help me God

(Signature) S. A. Berwick
Box 64 Great Bend, Kans. (Address)

SUBSCRIBED AND SWORN to before me this 29th day of November, 19 53
John W. Peas Notary Public.

My commission expires April 11, 1955

28-5091-s 8-50-16M

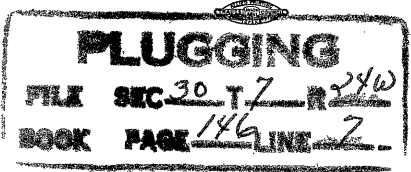

NOV 30, 1953