

FIRST  
CORRECTED

For KCC Use: 7-20-05  
Effective Date: \_\_\_\_\_  
District #: 2  
SGA?  Yes  No

KANSAS CORPORATION COMMISSION  
OIL & GAS CONSERVATION DIVISION

OWWO

Form C-1  
December 2002  
Form must be Typed  
Form must be Signed  
All blanks must be Filled

NOTICE OF INTENT TO DRILL

Must be approved by KCC five (5) days prior to commencing well

Expected Spud Date JULY 15 2005  
month day year

Spot  East  West  
NW - NW - NW Sec. 35 Twp. 25 S. R. 1  
330 feet from  N /  S Line of Section  
330 feet from  E /  W Line of Section

OPERATOR: License# 5446  
Name: BENJAMIN M GILES  
Address: 532 SOUTH MARKET  
City/State/Zip: WICHITA, KS 67202  
Contact Person: BENJAMIN M GILES  
Phone: 316 265 1992

Is SECTION  Regular  Irregular?  
(Note: Locate well on the Section Plat on reverse side)

County: SEDGWICK  
Lease Name: NEWCOMER Well #: A  
Field Name: HALEY

\* CONTRACTOR: 32701  
Name: C & G WELL SERVICE

Is this a Prorated / Spaced Field?  Yes  No  
Target Formation(s): HUNTON

Well Drilled For:  Oil  Gas  OWWO  Seismic; # of Holes  Other  
Well Class:  Enh Rec  Storage  Disposal  Other  
Type Equipment:  Infield  Pool Ext.  Wildcat  Other  
 Mud Rotary  Air Rotary  Cable

Nearest Lease or unit boundary: 330  
Ground Surface Elevation: 1398 feet MSL

Water well within one-quarter mile:  Yes  No  
Public water supply well within one mile:  Yes  No

Depth to bottom of fresh water: 150  
Depth to bottom of usable water: 180

Surface Pipe by Alternate:  1  2 212' SET  
Length of Surface Pipe Planned to be set: 220' ALREADY IN PLACE ok 2007

If OWWO: old well information as follows:  
Operator: ROSEN OIL CORPORATION  
Well Name: NEWCOMER A  
Original Completion Date: 10/20/71 Original Total Depth: 3428

Length of Conductor Pipe required: NONE  
Projected Total Depth: 3428

Formation at Total Depth: HUNTON

Directional, Deviated or Horizontal wellbore?  Yes  No

Water Source for Drilling Operations:  
 Well  Farm Pond Other HAULED-CITY WATER

If Yes, true vertical depth: \_\_\_\_\_

DWR Permit #: \_\_\_\_\_

Bottom Hole Location: \_\_\_\_\_

(Note: Apply for Permit with DWR )

KCC DKT #: \_\_\_\_\_

Will Cores be taken?  Yes  No

If Yes, proposed zone: \_\_\_\_\_

\* WAS: HAD-A-CALL WELL SERVICE, LLC 31538  
IS: C & G DRILLING, INC, LLC 32701

RECEIVED  
KANSAS CORPORATION COMMISSION  
JUL 15 2005

The undersigned hereby affirms that the drilling, completion and eventual plugging of this well will comply with K.S.A. 55 et. seq.  
It is agreed that the following minimum requirements will be met:

CONSERVATION DIVISION  
WICHITA, KS

1. Notify the appropriate district office **prior** to spudding of well;
2. A copy of the approved notice of intent to drill **shall be** posted on each drilling rig;
3. The minimum amount of surface pipe as specified below **shall be set** by circulating cement to the top; in all cases surface pipe shall be set through all unconsolidated materials plus a minimum of 20 feet into the underlying formation.
4. If the well is dry hole, an agreement between the operator and the district office on plug length and placement is necessary **prior to plugging**;
5. The appropriate district office will be notified before well is either plugged or production casing is cemented in;
6. If an ALTERNATE II COMPLETION, production pipe shall be cemented from below any usable water to surface within **120 days** of spud date. Or pursuant to Appendix "B" - Eastern Kansas surface casing order #133,891-C, which applies to the KCC District 3 area, alternate II cementing must be completed within 30 days of the spud date or the well shall be plugged. **In all cases, NOTIFY district office** prior to any cementing.

I hereby certify that the statements made herein are true and to the best of my knowledge and belief.

Date: 7-15-05 Signature of Operator or Agent: Benjamin M. Giles Title: Owner-Operator

For KCC Use ONLY  
API # 15 - 173-20082-0001  
Conductor pipe required: NONE feet  
Minimum surface pipe required: 212 feet per Alt. 1  
Approved by: RJP 7-15-05/RJP 8-1-05  
This authorization expires: 1-15-06  
(This authorization void if drilling not started within 6 months of effective date.)  
Spud date: \_\_\_\_\_ Agent: \_\_\_\_\_

Remember to:

- File Drill Pit Application (form CDP-1) with Intent to Drill;
- File Completion Form ACO-1 within 120 days of spud date;
- File acreage attribution plat according to field proration orders;
- Notify appropriate district office 48 hours prior to workover or re-entry;
- Submit plugging report (CP-4) after plugging is completed;
- Obtain written approval before disposing or injecting salt water.
- If this permit has expired (See: authorized expiration date) please check the box below and return to the address below.

Well Not Drilled - Permit Expired

Signature of Operator or Agent: \_\_\_\_\_  
Date: \_\_\_\_\_

Mail to: KCC - Conservation Division, 130 S. Market - Room 207B, Wichita, Kansas 67202

55  
25  
1  
E

**IN ALL CASES PLOT THE INTENDED WELL ON THE PLAT BELOW**

*Plat of acreage attributable to a well in a prorated or spaced field*

**If the intended well is in a prorated or spaced field, please fully complete this side of the form.** If the intended well is in a prorated or spaced field complete the plat below showing that the well will be properly located in relationship to other wells producing from the common source of supply. Please show all the wells and within 1 mile of the boundaries of the proposed acreage attribution unit for gas wells and within 1/2 mile of the boundaries of the proposed acreage attribution unit for oil wells.

API No. 15 - 173-20,082  
 Operator: BENJAMIN M GILES  
 Lease: NEWCOMER  
 Well Number: A  
 Field: HALEY

Number of Acres attributable to well: 10  
 QTR / QTR / QTR of acreage: NW - NW - NW

Location of Well: County: SEDGWICK  
 330 \_\_\_\_\_ feet from  N /  S Line of Section  
 330 \_\_\_\_\_ feet from  E /  W Line of Section  
 Sec. 35 Twp. 25 S. R. 1  East  West



Is Section:  Regular or  Irregular

**If Section is Irregular, locate well from nearest corner boundary.**

Section corner used:  NE  NW  SE  SW

**PLAT**

(Show location of the well and shade attributable acreage for prorated or spaced wells.)  
 (Show footage to the nearest lease or unit boundary line.)

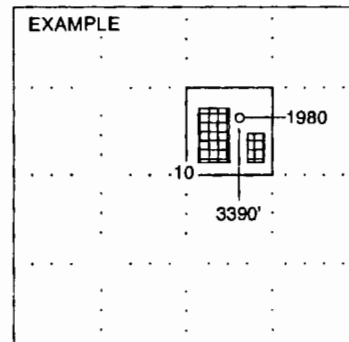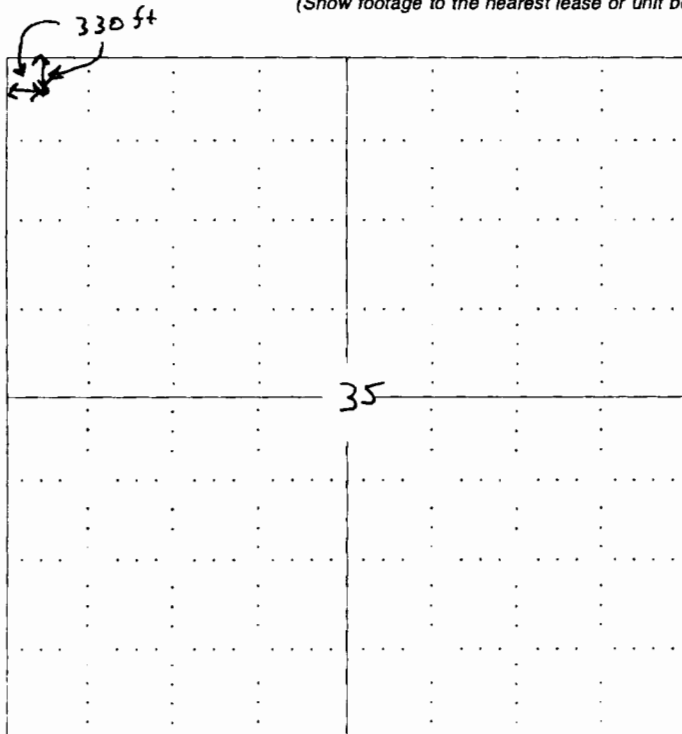

SEWARD CO.

**NOTE: In all cases locate the spot of the proposed drilling locaton.**

**In plotting the proposed location of the well, you must show:**

1. The manner in which you are using the depicted plat by identifying section lines, i.e. 1 section, 1 section with 8 surrounding sections, 4 sections, etc.
2. The distance of the proposed drilling location from the section's south / north and east / west.
3. The distance to the nearest lease or unit boundary line.
4. If proposed location is located within a prorated or spaced field a certificate of acreage attribution plat must be attached: (CO-7 for oil wells; CG-8 for gas wells).