

For KCC Use: Effective Date: 8-31-05 District #: 2 SGA?  Yes  No

KANSAS CORPORATION COMMISSION OIL & GAS CONSERVATION DIVISION NOTICE OF INTENT TO DRILL

RECEIVED

AUG 25 2005

Form C-1 December 2002 Form must be Typed Form must be Signed All blanks must be Filled

Must be approved by KCC five (5) days prior to commencing work

KCC WICHITA

Expected Spud Date: September 12 2005

Spot: Ap. Sw-NE NW SW Sec. 19 Twp. 16S S. R. 8  East  West 2100 feet from  N /  S Line of Section 950 feet from  E /  W Line of Section Is SECTION  Regular  Irregular?

OPERATOR: License# 33437 Name: Sedona Oil & Gas Corporation Address: 5646 Milton City/State/Zip: Dallas, TX 75206 Contact Person: Lang J. Fuqua Phone: (214) 368-6383, Extension 225

(Note: Locate well on the Section Plat on reverse side) County: Ellsworth Lease Name: Becker Trust Well #: 1 Field Name: Oxhide

CONTRACTOR: License# 33436 Name: Forrest Energy, LLC

Is this a Prorated / Spaced Field?  Yes  No Target Formation(s): Lansing-Kansas City & Arbuckle Nearest Lease or unit boundary: 950' West Ground Surface Elevation: 1699 feet MSL

Well Drilled For:  Oil  Gas  OWWO  Seismic; # of Holes  Other  Enh Rec  Storage  Disposal  Other Well Class:  Infield  Pool Ext.  Wildcat  Other Type Equipment:  Mud Rotary  Air Rotary  Cable

Water well within one-quarter mile:  Yes  No Public water supply well within one mile:  Yes  No Depth to bottom of fresh water: 180' Depth to bottom of usable water: 260'

If OWWO: old well information as follows: Operator: Well Name: Original Completion Date: Original Total Depth:

Surface Pipe by Alternate:  1  2 Length of Surface Pipe Planned to be set: 280' Length of Conductor Pipe required: None Projected Total Depth: 3800

Directional, Deviated or Horizontal wellbore?  Yes  No If Yes, true vertical depth: Bottom Hole Location: KCC DKT #:

Formation at Total Depth: Arbuckle Dolomite Water Source for Drilling Operations:  Well  Farm Pond Other: DWR Permit #:

(Note: Apply for Permit with DWR) Will Cores be taken?  Yes  No If Yes, proposed zone:

AFFIDAVIT

The undersigned hereby affirms that the drilling, completion and eventual plugging of this well will comply with K.S.A. 55 et. seq. It is agreed that the following minimum requirements will be met:

- 1. Notify the appropriate district office prior to spudding of well;
2. A copy of the approved notice of intent to drill shall be posted on each drilling rig;
3. The minimum amount of surface pipe as specified below shall be set by circulating cement to the top; in all cases surface pipe shall be set through all unconsolidated materials plus a minimum of 20 feet into the underlying formation.
4. If the well is dry hole, an agreement between the operator and the district office on plug length and placement is necessary prior to plugging;
5. The appropriate district office will be notified before well is either plugged or production casing is cemented in;
6. If an ALTERNATE II COMPLETION, production pipe shall be cemented from below any usable water to surface within 120 days of spud date. Or pursuant to Appendix "B" - Eastern Kansas surface casing order #133,891-C, which applies to the KCC District 3 area, alternate II cementing must be completed within 30 days of the spud date or the well shall be plugged. In all cases, NOTIFY district office prior to any cementing.

I hereby certify that the statements made herein are true and to the best of my knowledge and belief.

Date: August 23, 2005 Signature of Operator or Agent: Lang J. Fuqua Title: Geological Engineer

For KCC Use ONLY API # 15 - 053-21152-00-00 Conductor pipe required NONE feet Minimum surface pipe required 280' feet per Alt. 1 X Approved by: DPW 8-26-05 This authorization expires: 2-26-06 (This authorization void if drilling not started within 6 months of effective date.) Spud date: Agent:

Remember to:

- File Drill Pit Application (form CDP-1) with Intent to Drill;
- File Completion Form ACO-1 within 120 days of spud date;
- File acreage attribution plat according to field proration orders;
- Notify appropriate district office 48 hours prior to workover or re-entry;
- Submit plugging report (CP-4) after plugging is completed;
- Obtain written approval before disposing or injecting salt water.
- If this permit has expired (See: authorized expiration date) please check the box below and return to the address below.

Well Not Drilled - Permit Expired Signature of Operator or Agent: Date:

Mail to: KCC - Conservation Division, 130 S. Market - Room 2078, Wichita, Kansas 67202

19 16 8w

**IN ALL CASES PLOT THE INTENDED WELL ON THE PLAT BELOW**

*Plat of acreage attributable to a well in a prorated or spaced field*

**If the intended well is in a prorated or spaced field, please fully complete this side of the form.** If the intended well is in a prorated or spaced field complete the plat below showing that the well will be properly located in relationship to other wells producing from the common source of supply. Please show all the wells and within 1 mile of the boundaries of the proposed acreage attribution unit for gas wells and within 1/2 mile of the boundaries of the proposed acreage attribution unit for oil wells.

API No. 15 - 05321152000

Operator: Sedona Oil & Gas Corporation

Lease: Becker Trust

Well Number: 1

Field: Oxhide

Number of Acres attributable to well: \_\_\_\_\_

QTR / QTR / QTR of acreage: \_\_\_\_\_ - NW - SW

Location of Well: County: Ellsworth

2100 feet from  N /  S Line of Section

950 feet from  E /  W Line of Section

Sec. 19 Twp. 16S S. R. 8  East  West

Is Section:  Regular or  Irregular

**If Section is Irregular, locate well from nearest corner boundary.**



Section corner used:  NE  NW  SE  SW

**PLAT**

*(Show location of the well and shade attributable acreage for prorated or spaced wells.)*

*(Show footage to the nearest lease or unit boundary line.)*

RBW

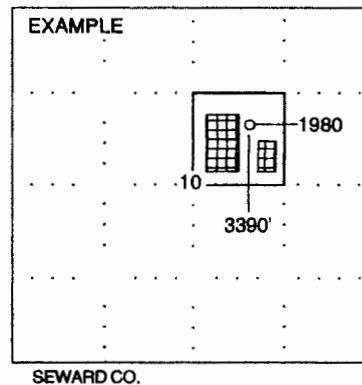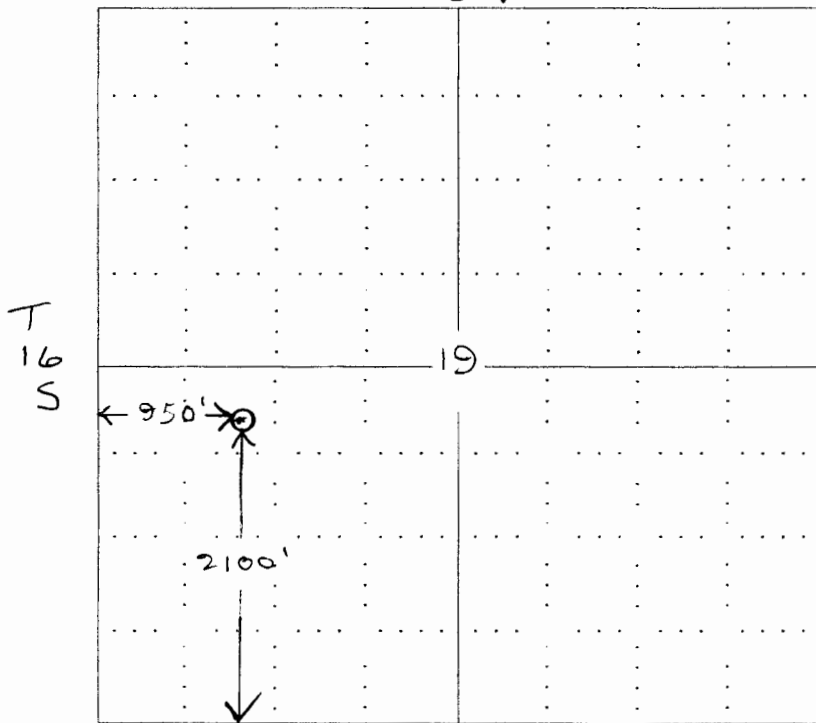

**NOTE: In all cases locate the spot of the proposed drilling location.**

Scale: 4" = 1 Mile

**In plotting the proposed location of the well, you must show:**

1. The manner in which you are using the depicted plat by identifying section lines, i.e. 1 section, 1 section with 8 surrounding sections, 4 sections, etc.
2. The distance of the proposed drilling location from the section's south / north and east / west.
3. The distance to the nearest lease or unit boundary line.
4. If proposed location is located within a prorated or spaced field a certificate of acreage attribution plat must be attached: (CO-7 for oil wells; CG-8 for gas wells).