

SIDE ONE

Two (2) copies of this form shall be filed with the Kansas Corporation Commission, 200 Colorado Derby Building, Wichita, Kansas 67202, within thirty (30) days after the completion of a well, regardless of how the well was completed.

F Attach separate letter of request if the information is to be held confidential. If confidential, only file one copy. Information on Side One will be of public record and Side Two will then be held confidential.

Applications must be made on dual completion, commingling, salt water disposal, injection and temporarily abandoned wells.

C Attach one copy only wireline logs (i.e. electrical log, sonic log, gamma ray neutron log, etc.). (Rules 82-2-105 & 82-2-125) KCC# (316) 263-3238.

LICENSE # 6343 EXPIRATION DATE 6-30-84
OPERATOR Yost Oil Operations API NO. 15-065, 21-491-00-00
ADDRESS Box 811 COUNTY Graham
Russell, Kansas 67665 FIELD W.C.


** CONTACT PERSON Jack Yost PHONE 913-483-6455 PROD. FORMATION Toronto

PURCHASER Clear Creek, Inc. LEASE Worcester F

ADDRESS 818 Century Plaza Bldg. Wichita, KS 67202 WELL NO. 16
WELL LOCATION NW SW NE

DRILLING Emphasis Drilling Company 1650 Ft. from North Line and
CONTRACTOR ADDRESS 120 West Third 2310 Ft. from East Line of
Russell, KS 67665 the NE (Qtr.) SEC 16 TWP 7, RGE 22

PLUGGING CONTRACTOR ADDRESS

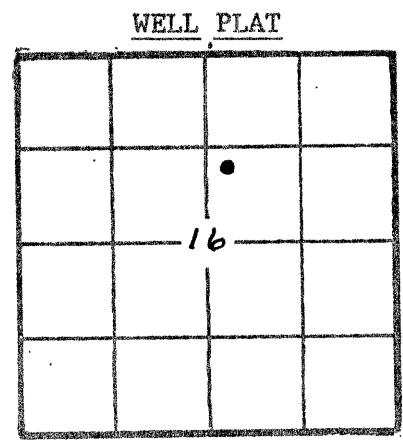

(Office Use Only)
KCC [checked]
KGS [checked]
SWD/REP
PLG.

TOTAL DEPTH 3895 PBDT
SPUD DATE 10-31-81 DATE COMPLETED 10-31-81
ELEV: GR 2338 DF 2341 KB 2343

DRILLED WITH (CABLE) (ROTARY) (AIR) TOOLS.
DOCKET NO. OF DISPOSAL OR REPRESSURING WELL BEING USED TO DISPOSE OF WATER FROM THIS LEASE

Amount of surface pipe set and cemented 275' DV Tool Used? NO

THIS AFFIDAVIT APPLIES TO: (Circle ONE) - Oil Gas, Shut-in Gas, Dry, Disposal, Injection, Temporarily Abandoned, OWWO. Other

ALL REQUIREMENTS OF THE STATUTES, RULES AND REGULATIONS PROMULGATED TO REGULATE THE OIL AND GAS INDUSTRY HAVE BEEN FULLY COMPLIED WITH.

A F F I D A V I T

Jack A. Yost, being of lawful age, hereby certifies that:

I am the Affiant, and I am familiar with the contents of the foregoing Affidavit. The statements and allegations contained therein are true and correct.

Signature of Jack A. Yost
YOST OIL OPERATIONS

SUBSCRIBED AND SWORN TO BEFORE ME this 25th day of July, 1983.

Lynn Hockersmith
NOTARY PUBLIC
State of Kansas
MY APPT. EXPIRES 6-20-87

Signature of Lynn Hockersmith
(NOTARY PUBLIC)

MY COMMISSION EXPIRES:

** The person who can be reached by phone regarding any questions concerning this information.

