

TO:
STATE CORPORATION COMMISSION
CONSERVATION DIVISION - PLUGGING
130 SOUTH MARKET, SUITE 2078
WICHITA, KANSAS 67202

API Well Number: 15-051-21963-00-00
Spot: SENENW Sec/Twnshp/Rge: 16-14S-16W
4290 feet from S Section Line, 2970 feet from E Section Line
Lease Name: HERTEL Well #: 1
County: ELLIS Total Vertical Depth: 3435 feet

Operator License No.: 30420
Op Name: INNONE, VINCENT D/B/A V.J.I. NATUR
Address: 30-38 48TH STREET
ASTORIA, NY 11103

PROD Size: 5.5 feet: 3435 w/175 sxs cmt
SURF Size: 8.625 feet: 209 w/125 sxs cmt

\$111⁶⁴

Well Type: OIL UIC Docket No: _____ Date/Time to Plug: 07/08/2005 2:00 PM
Plug Co. License No.: 33612 Plug Co. Name: GEIST, RON DBA WILDCAT WELL SERVICE
Proposal Rcvd. from: GARY SCHARD Company: VJI NATURAL RESOURCES, INC. Phone: (718) 274-3134

Proposed Plugging Method: Ordered out 150 sxs 60/40 pozmix - 10% gel - 500# hulls.
Retreivable plugs left at 3000'. Packer at 2516'. Packer at 2360'.
Well squeezed at 2493'-2600' w/75 sxs cement; 2343' w/unknown sxs cement; 320'-640' w/unknown sxs cement.
During drilling out - got out of pipe at 609'.

Plugging Proposal Received By: HERB DEINES WitnessType: COMPLETE (100%)
Date/Time Plugging Completed: 07/08/2005 4:00 PM KCC Agent: JAY PFEIFER

Actual Plugging Report:

Perfs:

TIH with tubing to 470' - hit hard TD.
Pulled up to 440' - mixed and circulated cement with 50 sxs.
POOH.
Swaged onto 5 1/2" - mixed and pumped 15 sxs cement. S.I.P. 300#.
Tied onto annulus and pumped 10 sxs cement. S.I.P. 250#.

RECEIVED
KANSAS CORPORATION COMMISSION
JUL 15 2005
CONSERVATION DIVISION
WICHITA, KS

Remarks: ALLIED CEMENTING COMPANY.

Plugged through: TBG

District: 04

HP-

Signed _____

Jay Pfeifer

(TECHNICIAN)

INVOICED

DATE 7-18-05


INV. NO 2006060049

Form CP-2/3

JUL 11 2005

JUL 15 2005

CONSERVATION DIVISION
WICHITA, KS

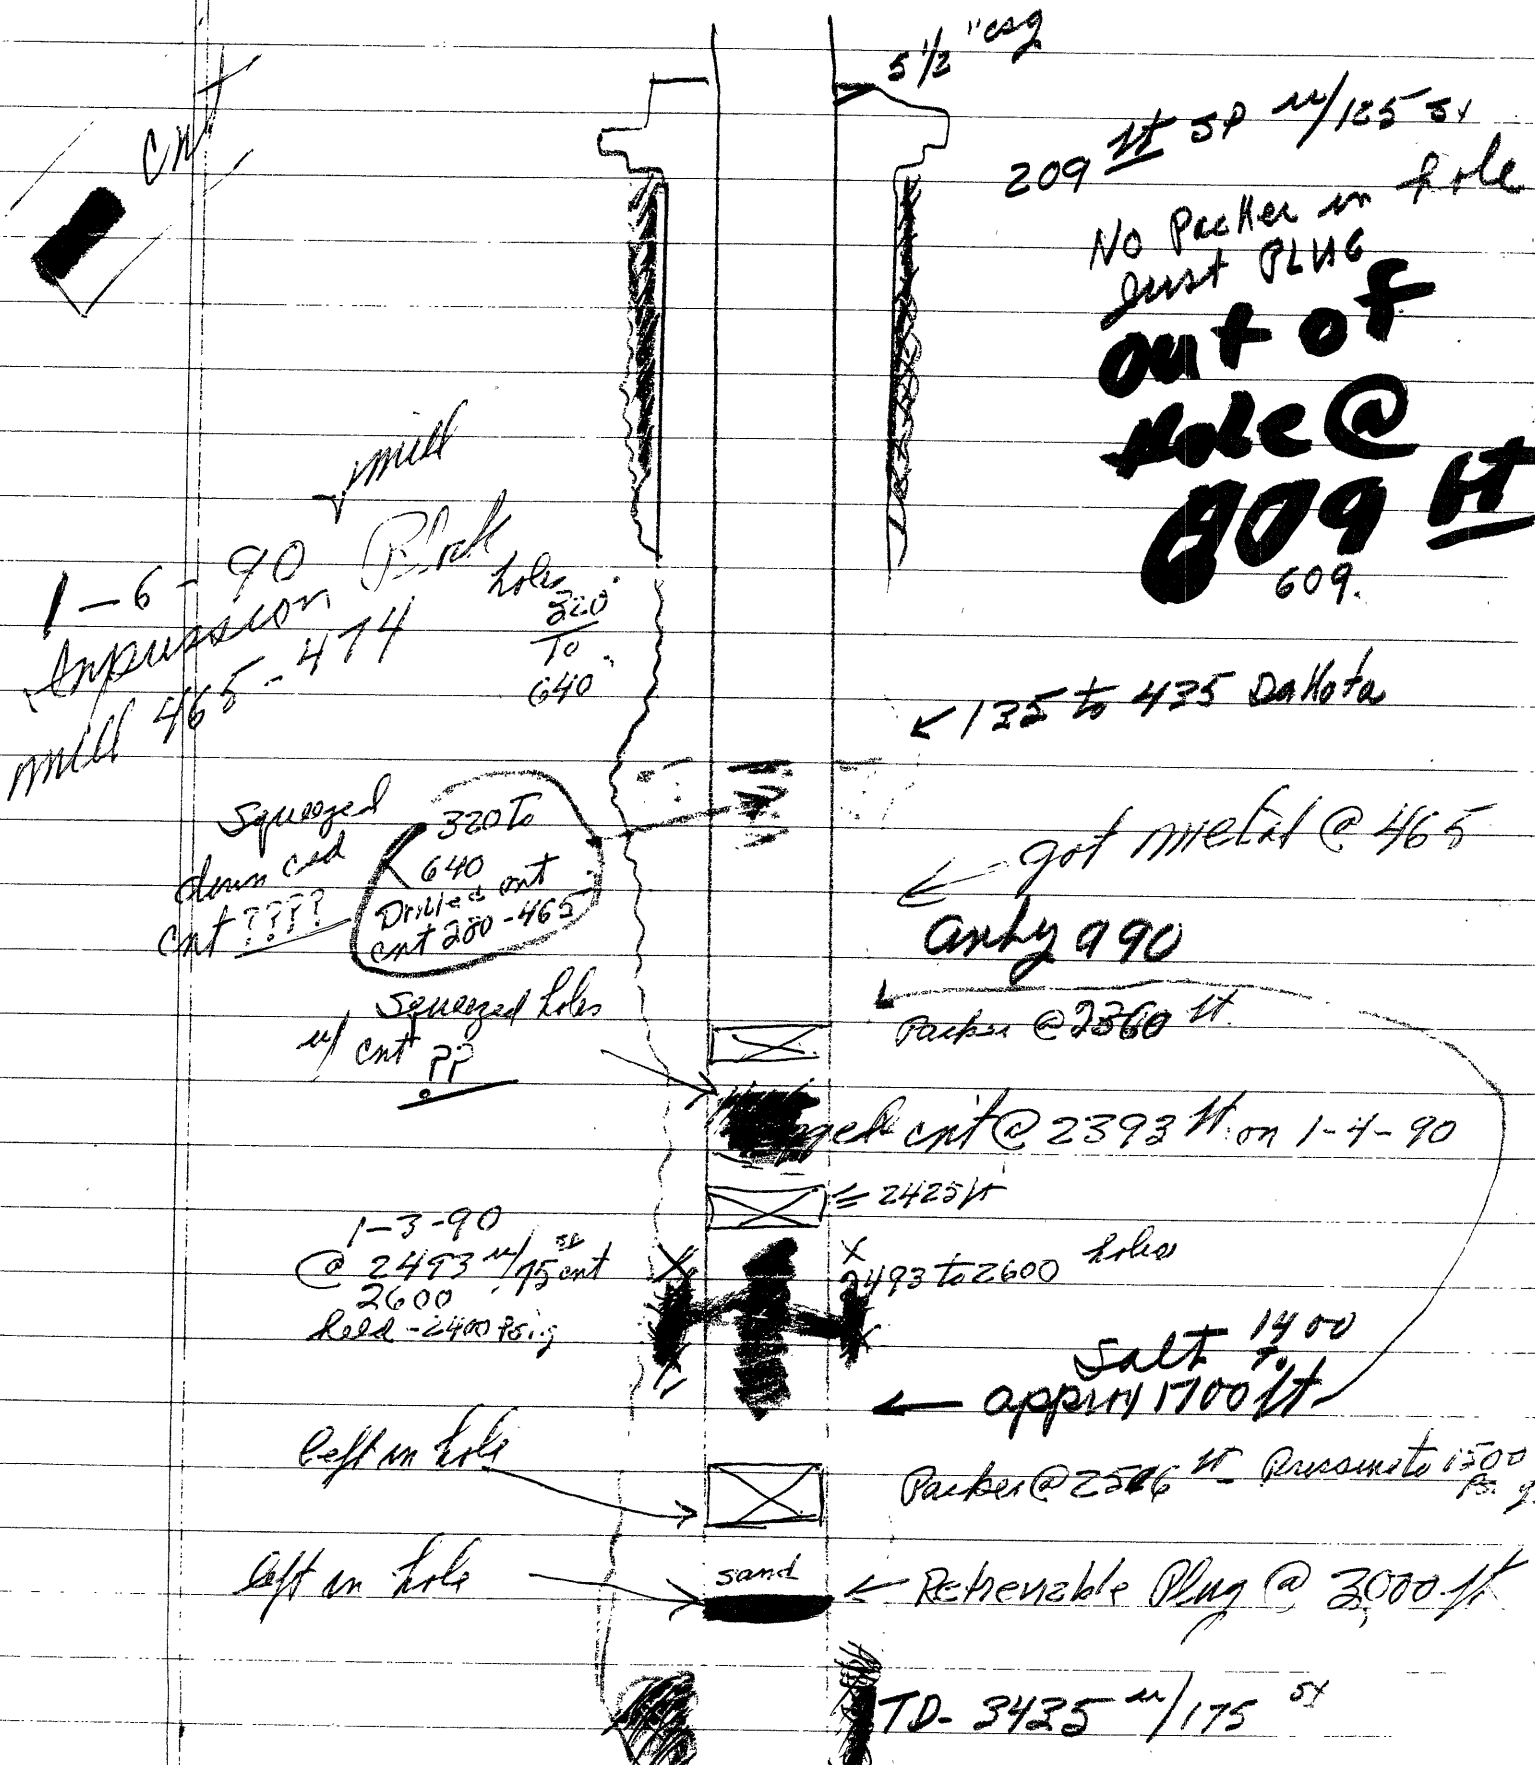

5 1/2" casing

209 ft SP w/ 125 ft

No packer in hole
just PLUG
out of hole @
809 ft
609.

mill

1-6-90 Black holes 320 to 640

mill 465-474

Squeezed down and cut????

320 to 640
Drilled out cut 200-465

Squeezed holes w/ cut PP

← 135 to 435 Dakota

← got metal @ 465

only 990

← Packer @ 2360 ft

1-3-90 @ 2493 w/ 95 cut 2600

held - 2400 psi

metal cut @ 2393 ft on 1-4-90

← 2425 ft

← 2493 to 2600 holes

Salt 1400

← approx 1700 ft

Packer @ 2506 ft. Pussan to 1300 ft

left on hole

← sand

← Retrievable Plug @ 3000 ft

TD - 3435 w/ 175 ft