

Starting Date: 6 12 85
month day year

State of Kansas

API Number 15- 065-22,1920000

C... NE NE Sec 12... Twp. 7... S, Rge. 21 ☐ East
(location) ☒ West

OPERATOR: License # 7076
Name Black Diamond Oil, Inc.....
Address 1105 E. 30th., Suite A.....
City/State/Zip Hays, Ks. 67601.....
Contact Person Kenneth Vehige.....
Phone 913 625-5891.....

CONTRACTOR: License # 8241
 Name Emphasis Oil Operations
 City/State Russell, Ks. 67665

Well Drilled For:	Well Class:	Type Equipment:
<input checked="" type="checkbox"/> Oil	<input type="checkbox"/> Infield	<input checked="" type="checkbox"/> Mud Rotary
<input type="checkbox"/> Gas	<input checked="" type="checkbox"/> Pool Ext.	<input type="checkbox"/> Air Rotary
<input type="checkbox"/> QWWO	<input type="checkbox"/> Wildcat	<input type="checkbox"/> Cable
<input type="checkbox"/> Swd		
<input type="checkbox"/> Inj		
<input type="checkbox"/> Expl		

Operator

Well Name

Comp Date **Old Total Depth**

Projected Total Depth feet**Projected Formation at TD**

Expected Producing Formations

...4620..... Ft North from Southeast Corner of Section
660..... Ft West from Southeast Corner of Section
 (Note: Locate well on Section Plat on reverse side)

Nearest lease or unit boundary line330..... feet.

CountyGraham.....

Lease NameRoberts..... Well# ..1.....

Domestic well within 330 feet : ☐ yes ☒ no

Municipal well within one mile : ☐ yes ☒ no

Depth to Bottom of fresh water 100 feet

Lowest usable water formation ... Dakota.....

Depth to Bottom of usable water 1125 feet

Surface pipe by Alternate : 1 ☐ 2 ☒

Surface pipe to be set 200 feet

Conductor pipe if any required ~~N/A~~ Est. 2/20 feet

Ground surface elevation feet MSL

This Authorization Expires 11-29-85

Approved By 5-29-85 K

I certify that we will comply with K.S.A. 55-101, et seq., plus eventually plugging hole to K.C.C. specifications.

Date 5/28/85 Signature of Operator or Agent [Signature] Title _____

.....President.....


Form C-1 4/84

~~SECRET~~ MHC/KOHE 5-29-75

RECEIVED
STATE CORPORATION COMMISSION

MAY 29 1985 5/29/85

A Regular Section of Land
7 Mile 5,280 Ft.
Wichita, Kansas

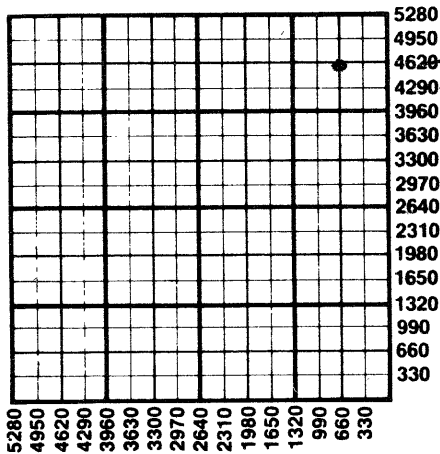

Must be filed with the K.C.C. five (5) days prior to commencing well
This card void if drilling not started within six (6) months of date received by K.C.C.

Important procedures to follow :

1. Notify District office before setting surface casing.
2. Set surface casing by circulating cement to the top.
3. File completion forms ACO-1 with K.C.C. within 90 days of well completion, following instructions on ACO-1, side 1, and including copies of wireline logs.
4. Notify District office 48 hours prior to old well workover or re-entry.
5. Prior to plugging, prepare a plugging plan, then obtain agreement from the appropriate district office for an approved plugging plan.
6. Submit plugging report (CP-4) to K.C.C. after plugging is completed.
7. Obtain an approved injection docket number before disposing of salt water.
8. Notify K.C.C. within 10 days when injection commences or terminates.
9. If an alternate 2 completion, cement in the production pipe from below any usable water to surface within 120 days of spud date.

State Corporation Commission of Kansas
Conservation Division
200 Colorado Derby Building
Wichita, Kansas 67202
(316) 263-3238