State of Kansas NOTICE OF INTENTION TO DRILL

CARD MUST BE SIGNED

(see rules on reverse side)

Starting Date		220	88	API Number 15— 065 – 22,438 ~ 00 – 00
month day year OPERATOR: License #				C-S/2 SW SE Sec. 29 Twp. 7 S, Rg. 21 XWest 330 Ft. from South Line of Section 1980 Ft. from East Line of Section (Note: Locate well on Section Plat on reverse side) Nearest lease or unit boundary line 330 feet County. Graham Lease Name. Stephen A Well # 1
Name Emphasis Oil Operations				Ground surface elevation21.00
City/StateBOX5.6RussellKs6.7.6.65				Domestic well within 330 feet:yes $\frac{X}{x}$ no
Well Drilled For	:	Well Class:	Type Equipment:	Municipal well within one mile:yes \underline{X} _no
X oil	SWD	Infield	X Mud Rotary	Depth to bottom of fresh water1.5.0
Gas	Inj	X Pool Ext.	Air Rotary	Depth to bottom of usable water11.25
owwo	Expl	Wildcat	Cable	Surface pipe by Alternate: 1 2 _X
If OWWO: old well info as follows:				Surface pipe planned to be set 20.0
Operator				Conductor pipe requiredNan.e
Well Name				Projected Total Depth3.750feet
Comp Date Old Total Depth Formation				FormationArbuckle
I certify that well will comply with K.S.A. 55-101, et seq., plus eventually plugging hole to KCC-specifications.				
I certify that well will comply with K.S.A. 55-101, et seq., plus eventually plugging hole to KCC specifications. Date 2/.1.5./88 Signature of Operator or Agent Kenneth Vehi je Title Owner./Operator For KCC Use:				
For KCC Use: Conductor Pipe Required				
Conductor Pipe Required				

EFFECTIVE DATE: 2-22-88


Must be filed with the K.C.C. five (5) days prior to commencing well This card void if drilling not started within six (6) months of date received by K.C.C.

Important procedures to follow:

- 1. Notify District office before setting surface casing.
- 2. Set surface casing by circulating cement to the top.
- 3. File completion forms ACO-1 with K.C.C. within 90 days of well completion, following instructions on ACO-1, side 1, and including copies of wireline logs.
- 4. Notify District office 48 hours prior to old well workover or re-entry.
- Prior to filing Intent, prepare a proposed plugging plan in case well is D & A, then obtain approval of plan when calling district office prior to setting surface pipe.
- 6. Submit plugging report (CP-4) to K.C.C. after plugging is completed.
- Obtain an approved injection docket number before disposing of salt water.
- Notify K.C.C. within 10 days when injection commences or terminates.
- 9. If an alternate 2 completion, cement in the production pipe from below any usable water to surface within 120 days of spud date.

State Corporation Commission of Kansas Conservation Division 200 Colorado Derby Building Wichita, Kansas 67202 (316) 263-3238

A Regular Section of Land 1 Mile = 5.280 Ft.

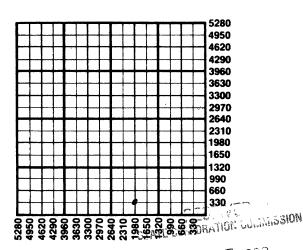

FEB 17 1988 CUNCTUM DEVISION WIGHTER, Kansas