


WELL PLUGGING RECORD

Give All Information Completely
Make Required Affidavit
Mail or Deliver Report to:
Conservation Division
State Corporation Commission
800 Bitting Building
Wichita, Kansas

NORTH

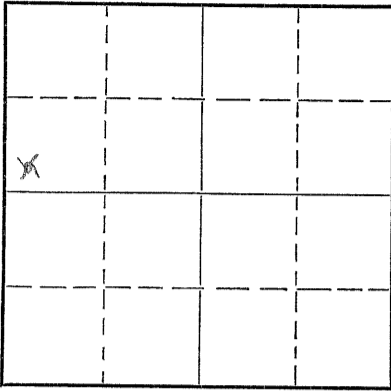

Locate well correctly on above
Section Plat

Graham County, Sec. 30 Twp. 7S Rge. 21 (E) W (W)
Location as "NE/CNW $\frac{1}{4}$ SW $\frac{1}{4}$ " or footage from lines SW SW NW
Lease Owner Deep Rock Oil Corporation
Lease Name Fabricius Well No. 1
Office Address Box #1051, Tulsa, Oklahoma
Character of Well (completed as Oil, Gas or Dry Hole) Dry Hole
Date well completed September 25 19 51
Application for plugging filed October 10 19 51
Application for plugging approved September 28 19 51
Plugging commenced September 23 19 51
Plugging completed September 25 19 51
Reason for abandonment of well or producing formation

If a producing well is abandoned, date of last production 19
Was permission obtained from the Conservation Division or its agents before plugging was commenced? Yes, permission obtained from Mr. Eldon Petty

Name of Conservation Agent who supervised plugging of this well Mr. Eldon Petty
Producing formation Arbuckle Depth to top 3736' Bottom 3845' Total Depth of Well 3845' Feet
Show depth and thickness of all water, oil and gas formations.

OIL, GAS OR WATER RECORDS

CASING RECORD

Formation	Content	From	To	Size	Put In	Pulled Out
				8-5/8	300'	None

Describe in detail the manner in which the well was plugged, indicating where the mud fluid was placed and the method or methods used in introducing it into the hole. If cement or other plugs were used, state the character of same and depth placed, from _____ feet to _____ feet for each plug set.

Filled hole with mud from 3845' to 325'. Set plug at 325', ran 45 sacks cement, filled to 312', ran 30 sacks cement filled up to 250'. Filled hole with heavy mud from 250' to 40'. Ran 10 sacks cement, filled to top of hole and into cellar.

(If additional description is necessary, use BACK of this sheet)

Correspondence regarding this well should be addressed to Deep Rock Oil Corporation
Address Box #1146, Hutchinson, Kansas

STATE OF Kansas, COUNTY OF Reno, ss.
Jack Smith (employee of owner) or (owner or operator) of the above-described well,
being first duly sworn on oath, says: That I have knowledge of the facts, statements, and matters herein contained and the log of the above-described well as filed and that the same are true and correct. So help me God.

(Signature) Jack Smith
Box #1146, Hutchinson, Kansas (Address)

SUBSCRIBED AND SWORN TO before me this 10th day of October, 1951

C. E. [Signature]
Notary Public.
RECEIVED
OCT 11 1951
STATE CORPORATION COMMISSION

My commission expires August 2, 1952 23-3273-s 4-50-10M

PLUGGING
FILE SEC 30 T 7 R 21W
PAGE 11X INT 29

Deep Rock Oil Corporation
 Fabricius Well No. 1
 Section 30-7S-21W
 Graham County, Kansas

FORMATION:

Surface clay, lime and rock	0'	175'
Shale and sand	175'	310'
Sand and shale	310'	985'
Shale and sand	985'	1550'
Anhydrite	1550'	1761'
Shale	1761'	1940'
Shale and lime	1940'	2180'
Shale and lime	2180'	2650'
Shale	2650'	2832'
Shale and lime	2832'	3095'
Shale	3095'	3185'
Lime and shale	3185'	3320'
Lime	3320'	3615'
Lime and shale	3615'	3734'
Lime	3734'	3845'
Total Depth		3845'

RECORDING
 FILE SEC 30 T 7 R 21W
 BOOK PAGE 112 LINE 29

OCT 11 1951
 OCT 11 1951