

STATE OF KANSAS
STATE CORPORATION COMMISSION


WELL PLUGGING RECORD

Give All Information Completely
Make Required Affidavit
Mail or Deliver Report to:
Conservation Division
State Corporation Commission
800 Biting Building
Wichita, Kansas

GRAHAM

County. Sec. 33 Twp. 7s Rge. 21w (E) (W)

Location as "NE/CNW/SW 1/4" or footage from lines SE* SE- SE-
Lease Owner KEATING DRILLING CO.
Lease Name W.K.I.T. SCHOOL Well No. 1
Office Address 510 NATL. BANK OF TULSA BLDG. TULSA OKLAHOMA
Character of Well (completed as Oil, Gas or Dry Hole) DRY
Date well completed 7-1-1952 19
Application for plugging filed 7-1-52 19
Application for plugging approved 7-1-52 19
Plugging commenced 7 A.M. 7-2-52 19
Plugging completed 10 A.M. 7-2-52 19
Reason for abandonment of well or producing formation Dry

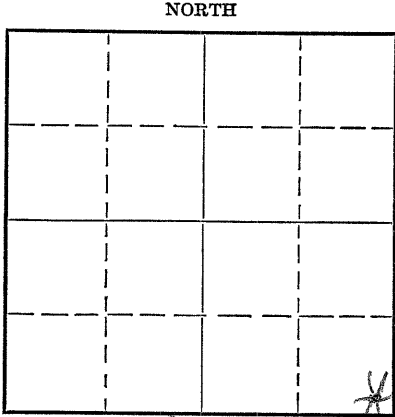

Locate well correctly on above Section Plat

If a producing well is abandoned, date of last production 19
Was permission obtained from the Conservation Division or its agents before plugging was commenced? Yes

Name of Conservation Agent who supervised plugging of this well Mr. Eldon Petty
Producing formation none Depth to top Bottom Total Depth of Well 3655 Feet
Show depth and thickness of all water, oil and gas formations.

OIL, GAS OR WATER RECORDS

CASING RECORD

Formation	Content	From	To	Size	Put In	Pulled Out
				8 5/8	193	Cement circ.

Describe in detail the manner in which the well was plugged, indicating where the mud fluid was placed and the method or methods used in introducing it into the hole. If cement or other plugs were used, state the character of same and depth placed, from feet to feet for each plug set.

Hole filled to 180 ft. with mud pushed plug to top of mud run 15 sacks cement on top of plug through drill pipe then filled hole with mud to 40 ft. run 1/2 sack hulls and 10 sacks cement filled hole to bottom of cellar

RECEIVED
STATE CORPORATION COMMISSION
JUL 7 1952
CONSERVATION DIVISION
Wichita, Kansas

(If additional description is necessary, use BACK of this sheet)

Correspondence regarding this well should be addressed to Keating Drilling Co.
Address 510 Natl. Bank of Tulsa Bldg. Tulsa Oklahoma

STATE OF Kansas, COUNTY OF Rooks, ss.
Hugh Brittain (employee of owner) or (owner or operator) of the above-described well, being first duly sworn on oath, says: That I have knowledge of the facts, statements, and matters herein contained and the log of the above-described well as filed and that the same are true and correct. So help me God.

(Signature) Hugh Brittain
% Sweet, Abstract Co. Wichita, Kansas
(Address)

SUBSCRIBED AND SWORN TO before me this 3 day of July 1952

Charles Hageman
Notary Public.

My commission expires 11-14-53

PLUGGING
FILE SEC 33 TWP 7 R 21 W
BOOK PAGE 28 LINE 15

COMPANY: Keating Drilling Co, 510 Natl. Bank of Tulsa Bldg. Tulsa 3, Okla.

FARM: W.K.I.T. School Well No. 1 Loc: SE SE SE Sec 33-7-21W
 TOTAL DEPTH 3655' County: Graham, Kansas
 TOOLS: Keating Drilling Company Elev.: 2068 KB
 CASING: 197' of 8 5/8" (KB) Time Log: Geolograph
 Elec. Log: Schlumberger

0- 220 clays & gravel
 220 - 450 shale
 450- 500 shale & sand
 500-1100 shale & shells
 1100-1170 sand & shale
 1170-1400 sand
 1400-1587 sand & shale
 1587-1670 red beds
 1670-1734 anhydrite
 1734-2247 shale
 2247-2410 sdy shale & lime
 2410-2507 sand, shale & lime
 2507-2521 sand
 2521-2635 sand & shale
 2635-2755 sandy shale
 2755-2910 sand & shale
 2910-2975 shale
 2975-3010 shale & lime
 3010-3145 lime
 3145-3215 lime & shale
 3215-3280 lime
 3280-3523 shale & lime
 3523-3583 sandy shale
 3583-3615 conglomerate
 3615-3655 lime

TD 3655

Geol. Tops	
Anhydrite	1670
Topeka	3073
Heebner	3284
Toronto	3306
LKC	3321
B/KC	3521
Cong.	3586 (upper 2' sd).
Arbuckle	3614
T.D. (in Arb)	3655

NO SHOWS

Tr. spotted stain, tight 3453-57
 Poor, cryst. poros, lt. spot. st. 3478-94
 Tr. spot. stain, tight 3501-10
 Good Porosity, wtr. 3619-TD

State of Kansas County of Sedgwick S.S.

Dale Martin, representative of operator of above described well, being first duly sworn on oath, states - That I have knowledge of the facts, statements and matters herein contained, and the log of the above well, as filed, and that the same are true and correct. So help me God.

Signature Dale Martin
 836 Marcilene, Wichita, Kans.

Subscribed and sworn to before me this 7th day of July 1952

My Commission Expires:
March 26, 1955

Helen G. Langston
 Notary Public

