

15-065-02699-00-00

STATE OF KANSAS
STATE CORPORATION COMMISSION
Give All Information Completely
Make Required Affidavit
Mail or Deliver Report to:
Conservation Division
State Corporation Commission
800 Bittling Building
Wichita, Kansas

WELL PLUGGING RECORD

OR
FORMATION PLUGGING RECORD

Strike out upper line
when reporting plug-
ging of formations.

Graham County. Sec. 31 Twp. 7s Rge. (E) 21 (W)

Location as "NE $\frac{1}{4}$ NW $\frac{1}{4}$ SW $\frac{1}{4}$ " or footage from lines NW NW NW

Lease Owner. Hollow Drilling Company, et al

Lease Name. J. M. Wiesner Well No. 1

Office Address. 210 Schweiter Bldg., Wichita 2, Kansas

Character of Well (completed as Oil, Gas or Dry Hole) Dry Hole

Date well completed. 9-18-1943

Application for plugging filed. 9-18-1943

Application for plugging approved. 9-18-1943

Plugging commenced. 9-18-1943

Plugging completed. 9-19-1943

Reason for abandonment of well or producing formation. Dry Hole


If a producing well is abandoned, date of last production. Dry Hole 19

Was permission obtained from the Conservation Division or its agents before plugging was commenced? Yes

Name of Conservation Agent who supervised plugging of this well. C. T. Alexander

Producing formation. -- Depth to top. -- Bottom. -- Total Depth of Well. 3755 Feet

Show depth and thickness of all water, oil and gas formations.

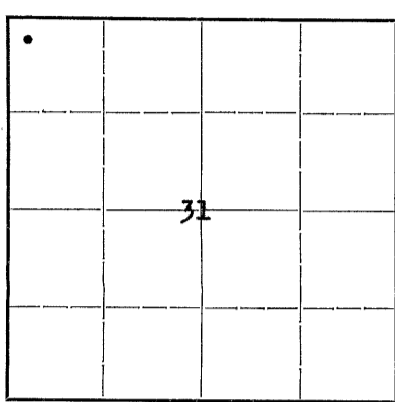

Locate well correctly on above
Section Plat

OIL, GAS OR WATER RECORDS

CASING RECORD

Formation	Content	From	To	Size	Put In	Pulled Out
Surface	Water	0	203	8	203'	None


Describe in detail the manner in which the well was plugged, indicating where the mud fluid was placed and the method or methods used in introducing it into the hole. If cement or other plugs were used, state the character of same and depth placed, from feet to feet for each plug set.

Filled with heavy mud from 3755 to 203'--Bridge and 15 sacks cement plug 203'--158'.

Heavy mud from 158' to 26'. Wood bridge and cement (5 sacks). Plug 26' to 6'.

Cement and mud put in hole through drill pipe.

31 7 21W
92 2

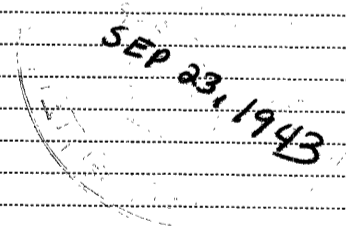

(If additional description is necessary, use BACK of this sheet)

Correspondence regarding this well should be addressed to. Hollow Drilling Company, Inc.
Address. 210 Schweiter Bldg. Wichita 2, Kansas

STATE OF Kansas, COUNTY OF Sedgwick, ss.
W. B. Hollow (employee of owner) or (owner or operator) of the above-described well,

being first duly sworn on oath, says: That I have knowledge of the facts, statements, and matters herein contained and the log of the above-described well as filed and that the same are true and correct. So help me God.

(Signature) W. B. Hollow

(Address) Imman Kansas

SUBSCRIBED AND SWORN TO before me this 22nd day of September, 1943.

My commission expires February 4, 1946

Ella Mae Custer
Notary Public.

HOLLOW DRILLING COMPANY, INC.
210 Schweiter Building
Wichita (2), Kansas

Well Log---J. M. Wiesner #1
NW/4 NW/4 NW/4, Sec. 31-7s-21w
Graham County, Kansas
Elevation---2191 LAS

Casing Record:
8 1/2" Surface pipe cemented @ 203' with
230 sacks bulk cement.

Date Started---7-12-43
Date Completed-9-19-43

Rotary Tools -- 0--3755'

Contractor--Hollow Drilling Company, Inc.

Log		Tops
0	42	Surface sand & Clay
42	203	Shale & Lime Shells
203	523	Shale & Shells
523	781	Soft Shale
781	967	Sand & Shells
967	1200	Lime, Shale, & Sand
1200	1500	Sand
1500	1640	Shale & Shells
1640	1770	Sand & Shells
1770	1810	Anhydrite & Part Iron
1810	1815	Anhydrite Lime
1815	1900	Lime
1900	1995	Lime & Shale breaks
1995	2040	Lime & Shale
2040	2100	Shale
2100	2168	Sandy Shale & Shells
2168	2200	Lime & Shale
2200	2238	Lime
2238	2318	Lime & Shale
2318	2440	Shale & Lime Shells
2440	2465	Lime
2465	2490	Lime & Shale
2490	2507	Shale
2507	2530	Lime
2530	2540	Lime & Shale
2540	2620	Shale & Lime Shells
2620	2660	Lime
2660	2714	Shale & Lime Shells
2714	2793	Lime & Shale
2793	2800	Hard Sand
2800	2815	Lime
2815	2830	Sandy Lime
2830	2842	Lime
2842	2880	Shale
2880	3000	Lime & Shale
3000	3045	Shale
3045	3097	Lime
3097	3205	Lime & Shale
3205	3206	Chert
3206	3208	Lime
3208	3242	Lime, some Chert
3242	3259	Lime & Shale
3259	3277	Sandy Lime
3277	3317	Lime shells
3317	3340	Lime & Shale breaks
3340	3364	Shale
3364	3402	Lime & Shale
3402	3636	Lime
3636	3647	Lime & Shale
3647	3667	Shale & Lime
3667	3697	Shale
3697	3704	Conglomerate
3704	3717	Chert
3717	3735	Shale & Chert
3735	3755	Lime
3755		T.D.

Top Topeka	3165
Top K. C. Lime	3412
Top Penn. Basal Cong.	3695
Top Arbuckle	3733

I, J. M. Wiesner, do hereby certify the above to be the log on the well herein captioned to the best of my knowledge and belief.

HOLLOW DRILLING COMPANY, INC.,

By J. M. Wiesner

31 7 21W
92 2

267 301 1010

Plugged and abandoned 9-19-43