

CARD MUST BE TYPED

State of Kansas

CARD MUST BE SIGNED

NOTICE OF INTENTION TO DRILL

(see rules on reverse side)

Expected Spud Date..... 11/16/87
month day year

API Number 15-21-26, 871-00-00 ^{XX}
NW SW NW 1 16 21 — East
Sec 3770 Twp. S, Rg. — West
5115 Ft. from South Line of Section
Ft. from East Line of Section

OPERATOR: License # 5688
Name PIONEER PETROLEUM
Address 116 A. W. 3RD STREET
City/State/Zip OTTAWA, KS 66067
Contact Person. GEORGE SELL
Phone (913) 242-4499

(Note: Locate well on Section Plat on reverse side)
Nearest lease or unit boundary line 165 feet
County MIAMI
Lease Name. MOSHER Well # WS 1

CONTRACTOR: License # 5666
Name FINCH DRILLING
City/State OTTAWA, KS 66067

Ground surface elevation feet MSL
Domestic well within 330 feet: —yes ^{XX}no
Municipal well within one mile: —yes ^{XX}no

Well Drilled For: Well Class: Type Equipment:
 Oil Storage Infield Mud Rotary
 Gas Inj Pool Ext. Air Rotary
 OWWO Expl Wildcat Cable

Depth to bottom of fresh water.....
Depth to bottom of usable water 200
Surface pipe by Alternate: 1 2 ^{XX}
Surface pipe planned to be set 20

If OWWO: old well info as follows:
Operator
Well Name
Comp Date Old Total Depth.....

Conductor pipe required
Projected Total Depth 1100 feet
Formation MISSISSIPPIAN

I certify that well will comply with K.S.A. 55-101, et seq., plus eventually plugging hole to KCC specifications.
Date 11/06/87 Signature of Operator or Agent Geoff Engleman Title AS AGENT

For KCC Use:
Conductor Pipe Required feet; Minimum Surface Pipe Required feet per Alt. ²⁰ 2
This Authorization Expires 5-6-88 Approved By Per. 11-6-87


EFFECTIVE DATE: 11-11-87

Must be filed with the K.C.C. five (5) days prior to commencing well
 This card void if drilling not started within six (6) months of date received by K.C.C.

Important procedures to follow:

1. Notify District office before setting surface casing.
2. Set surface casing by circulating cement to the top.
3. File completion forms ACO-1 with K.C.C. within 120 days of well spud date, following instructions on ACO-1, side 1, and including copies of wireline logs.
4. Notify District office 48 hours prior to old well workover or re-entry.
5. Prior to filing Intent, prepare a proposed plugging plan in case well is D & A, then obtain approval of plan when calling district office prior to setting surface pipe.
6. Submit plugging report (CP-4) to K.C.C. after plugging is completed.
7. Obtain an approved injection docket number before disposing of salt water.
8. Notify K.C.C. within 10 days when injection commences or terminates.
9. If an alternate 2 completion, cement in the production pipe from below any usable water to surface within 120 days of spud date.

**A Regular Section of Land
 1 Mile = 5,280 Ft.**

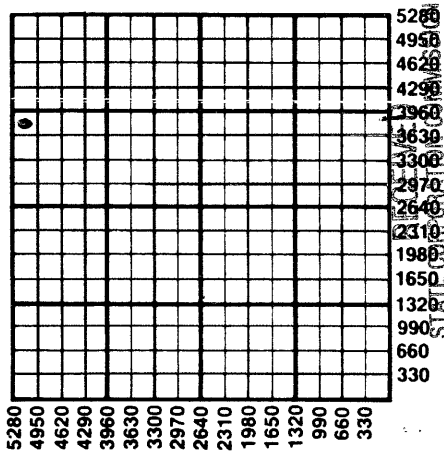

NOV 6 1987

CONSERVATION DIVISION
 Wichita, Kansas

State Corporation Commission of Kansas
 Conservation Division
 200 Colorado Derby Building
 Wichita, Kansas 67202-1212
 (316) 263-3238