

CARD MUST BE TYPED

State of Kansas  
**NOTICE OF INTENTION TO DRILL**  
(see rules on reverse side)

CARD MUST BE SIGNED

Starting Date: ..... 3 ..... 16 ..... 1985 .....  
month day year

API Number 15- 121-26, 498-00  
SW/SW Sec 35 Twp 15 S, Rge 21E  East  
(location)  West

OPERATOR: License # 9688 .....

Name Rock Oil Company .....

Address 439 Putter .....

City/State/Zip Wichita, Kansas 67212 .....

Contact Person Lloyd R. Nuckolls .....

Phone 316-721-3890 .....

CONTRACTOR: License # 5955 .....

Name Pioneer Oil Company .....

City/State Paola, Kansas .....

495 Ft North from Southeast Corner of Section  
4785 Ft West from Southeast Corner of Section  
(Note: Locate well on Section Plat on reverse side)

Nearest lease or unit boundary line ..... feet.

County Miami .....

Lease Name Folks "B" Well# 5 .....

Domestic well within 330 feet:  yes  no

Municipal well within one mile:  yes  no

Well Drilled For: Well Class: Type Equipment:

- Oil  Swd  Infield  Mud Rotary
- Gas  Inj  Pool Ext.  Air Rotary
- OWWO  Expl  Wildcat  Cable

Depth to Bottom of fresh water ..... 200\* ..... feet

Lowest usable water formation .....

Depth to Bottom of usable water ..... 200 ..... feet

Surface pipe by Alternate: 1  2

Surface pipe to be set ..... 21' ..... feet

Conductor pipe if any required .....

Ground surface elevation ..... feet MSL

This Authorization Expires 9-11-85 .....

Approved By 3-11-85 *[Signature]* .....

I certify that we will comply with K.S.A. 55-101, et seq., plus eventually plugging hole to K.C.C. specifications.

Date 3/10/85 Signature of Operator or Agent *[Signature]* Title owner

MHC/WONE 3-11-85 Form C-1 4/84

Must be filed with the K.C.C. five (5) days prior to commencing well  
 This card void if drilling not started within six (6) months of date received by K.C.C.


NOISIAID NOITVAESNOJ

MAR 11 1985  
 3-11-85

STATE CORPORATION COMMISSION  
 A Regular Section of Land  
 1 Mile = 5,280 Ft.

**Important procedures to follow :**

1. Notify District office before setting surface casing.
2. Set surface casing by circulating cement to the top.
3. File completion forms ACO-1 with K.C.C. within 90 days of well completion, following instructions on ACO-1, side 1, and including copies of wireline logs.
4. Notify District office 48 hours prior to old well workover or re-entry.
5. Prior to plugging, prepare a plugging plan, then obtain agreement from the appropriate district office for an approved plugging plan.
6. Submit plugging report (CP-4) to K.C.C. after plugging is completed.
7. Obtain an approved injection docket number before disposing of salt water.
8. Notify K.C.C. within 10 days when injection commences or terminates.
9. If an alternate 2 completion, cement in the production pipe from below any usable water to surface within 120 days of spud date.

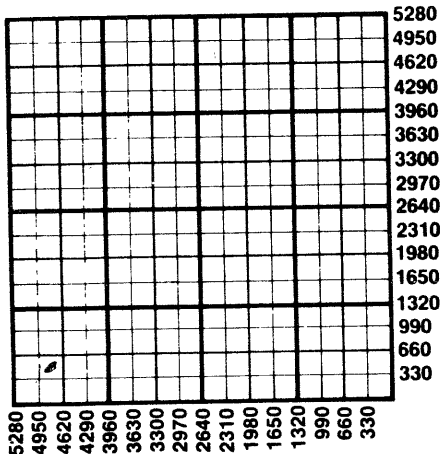

State Corporation Commission of Kansas  
 Conservation Division  
 200 Colorado Derby Building  
 Wichita, Kansas 67202  
 (316) 263-3238