

CARD MUST BE TYPED

State of Kansas

CARD MUST BE SIGNED

NOTICE OF INTENTION TO DRILL

(see rules on reverse side)

Starting Date ... 11 13 1985
month day year

API Number 15— 121-26,705-0000
4:15

OPERATOR: License # 8509
Name .. Evans. Energy. Development. *EUC*
Address 401 S. Main, #11
City/State/Zip .. Ottawa, KS. 66067
Contact Person..... Glen. Evans
Phone 913. 242. 5733

App. SE NE NW
Sec. 36... Twp... 15 S, Rg... 22...
4170 Ft. from South Line of Section
3180 Ft. from East Line of Section

(Note: Locate well on Section Plat on reverse side)

CONTRACTOR: License #
Name Company. tools
City/State

Nearest lease or unit boundary line 650 feet
County Miami

Well Drilled For: Well Class: Type Equipment:
 Oil SWD Infield Mud Rotary
 Gas Inj Pool Ext. Air Rotary
 OWWO Expl Wildcat Cable

Lease Name... Messer Well #... 1
Ground surface elevation feet MSL

If OWWO: old well info as follows:
Operator
Well Name
Comp Date Old Total Depth.....

Domestic well within 330 feet: yes no
Municipal well within one mile: yes no
Surface pipe by Alternate: 1 2
Depth to bottom of fresh water 26
Depth to bottom of usable water 200
Surface pipe planned to be set 20
Projected Total Depth 1000 feet
Formation.....

I certify that well will comply with K.S.A. 55-101, et seq., plus eventually plugging hole to KCC specifications.

pet/KCC

_____ cementing will be done immediately upon setting production casing.

Date .. 11/12/85 Signature of Operator or Agent *Clairne Barkman* Title as agent ...

For KCC Use:

Conductor Pipe Required feet; Minimum Surface Pipe Required feet per Alt. 1 2

This Authorization Expires 5-12-86 Approved By 11-12-85 *R*

Must be filed with K.C.C. (5) days prior to commencing well
 This card void if registration started within six (6) months of date received by K.C.C.


RECEIVED
 STATE CORPORATION COMMISSION
 NOV 12 1985

Important procedures to follow:

A Regular Section of Land
1 Mile = 5,280 Ft.

CONSERVATION DIVISION
 Wichita, Kansas

1. Notify District office before setting surface casing.
2. Set surface casing by circulating cement to the top.
3. File completion forms ACO-1 with K.C.C. within 90 days of well completion, following instructions on ACO-1, side 1, and including copies of wireline logs.
4. Notify District office 48 hours prior to old well workover or re-entry.
5. Prior to filing Intent, prepare a proposed plugging plan in case well is D & A, then obtain approval of plan when calling district office prior to setting surface pipe.
6. Submit plugging report (CP-4) to K.C.C. after plugging is completed.
7. Obtain an approved injection docket number before disposing of salt water.
8. Notify K.C.C. within 10 days when injection commences or terminates.
9. If an alternate 2 completion, cement in the production pipe from below any usable water to surface within 120 days of spud date.

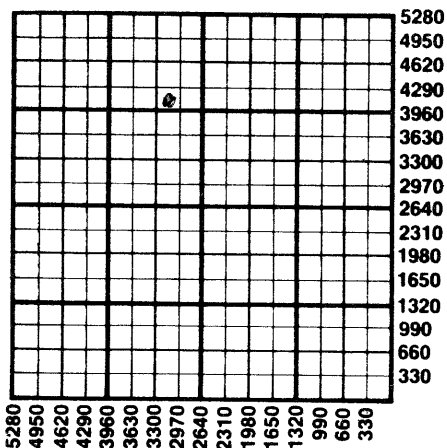

State Corporation Commission of Kansas
 Conservation Division
 200 Colorado Derby Building
 Wichita, Kansas 67202
 (316) 263-3238