

CARD MUST BE TYPED

State of Kansas

CARD MUST BE SIGNED

NOTICE OF INTENTION TO DRILL

(see rules on reverse side)

Starting Date 5 12 87
month day year

API Number 15— 065-01017-00-01

OPERATOR: License # 6033
Name Murfin Drilling Company
Address 250 N. Water, Suite 300
City/State/Zip Wichita, Ks. 67202
Contact Person Larry Jack
Phone 316-267-3241

..... SE NE. Sec. 6 Twp. 7 S, Rg. 22 .. West
..... 3300 Ft. from South Line of Section
..... 660 Ft. from East Line of Section

(Note: Locate well on Section Plat on reverse side)

CONTRACTOR: License # 6033
Name Murfin Drilling Company
City/State Wichita, Ks. 67202

Nearest lease or unit boundary line 330 feet
County Graham
Lease Name MILDREXTER Well # SWD 1

Well Drilled For: Well Class: Type Equipment:
— Oil SWD — Infield Mud Rotary
— Gas — Inj — Pool Ext. — Air Rotary
 OWWO — Expl — Wildcat — Cable

Ground surface elevation 2363 feet MSL
Domestic well within 330 feet: —yes no
Municipal well within one mile: —yes no

If OWWO: old well info as follows:
Operator .. Murfin Drilling & Rains & Williamson
Well Name .. Mildrexter B. #3
Comp Date 6-12-59 .. Old Total Depth 3820

Depth to bottom of fresh water 100' / 150'
Depth to bottom of usable water 1200
Surface pipe by Alternate: 1 1/2" 2X
Surface pipe ~~planned to be~~ set ... 2050 & .cmt. to surf. ...
Conductor pipe required ... 212' - 8-5/8" existing
Projected Total Depth 2100' feet
Formation

I certify that well will comply with K.S.A. 55-101, et seq., plus eventually plugging hole to KCC specifications.
Date 5-6-87 Signature of Operator or Agent Larry Jack Title. Asst Prod. Mgr


For KCC Use:
Conductor Pipe Required feet; Minimum Surface Pipe Required 212 feet per Alt. 2
This Authorization Expires 11-11-87 Approved By [Signature]

Must be filed with the K.C.C. five (5) days prior to commencing well
 This card void if drilling not started within six (6) months of date received by K.C.C.

Important procedures to follow:

1. Notify District office before setting surface casing.
2. Set surface casing by circulating cement to the top.
3. File completion forms ACO-1 with K.C.C. within 90 days of well completion, following instructions on ACO-1, side 1, and including copies of wireline logs.
4. Notify District office 48 hours prior to old well workover or re-entry.
5. Prior to filing Intent, prepare a proposed plugging plan in case well is D & A, then obtain approval of plan when calling district office prior to setting surface pipe.
6. Submit plugging report (CP-4) to K. C. C. after plugging is completed.
7. Obtain an approved injection docket number before disposing of salt water.
8. Notify K.C.C. within 10 days when injection commences or terminates.
9. If an alternate 2 completion, cement in the production pipe from below any usable water to surface within 120 days of spud date.

A Regular Section of Land
1 Mile = 5,280 Ft.

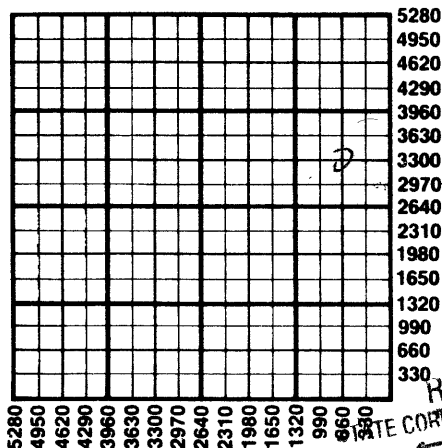

RECEIVED
 STATE CORPORATION COMMISSION
 05-11-87
 MAY 11 1987
 CONSERVATION DIVISION
 Wichita, Kansas

State Corporation Commission of Kansas
 Conservation Division
 200 Colorado Derby Building
 Wichita, Kansas 67202
 (316) 263-3238