

CARD MUST BE TYPED

State of Kansas

CARD MUST BE SIGNED

NOTICE OF INTENTION TO DRILL

(see rules on reverse side)

Starting Date Feb. 12 1986
month day year

API Number 15- 121-26,743-00-00
11:20

OPERATOR: License # 4441
Name Reusch Well Service, Inc.
Address 401 S. Main
City/State/Zip Ottawa, Kansas 66067
Contact Person Liz Reusch
Phone 913 242-5733

app. NE NE NE... Sec. 23... Twp. 15... S, Rg. 21...
5015... Ft. from South Line of Section
495... Ft. from East Line of Section

(Note: Locate well on Section Plat on reverse side)

CONTRACTOR: License # 4441
Name same as above
City/State

Nearest lease or unit boundary line 495..... feet
County Miami
Lease Name D. Thorn Well # 2

Well Drilled For: Well Class: Type Equipment:
 Oil SWD Infield Mud Rotary
 Gas Inj Pool Ext. Air Rotary
 OWWO Expl Wildcat Cable

Ground surface elevation feet MSL
Domestic well within 330 feet: yes no
Municipal well within one mile: yes no

If OWWO: old well info as follows:

Operator
Well Name
Comp Date Old Total Depth.....

Depth to bottom of fresh water 26.....
Depth to bottom of usable water 200.....
Surface pipe by Alternate: 1 2
Surface pipe planned to be set 20.....
Conductor pipe required
Projected Total Depth 800..... feet
Formation Squirrel.....

I certify that well will comply with K.S.A. 55-101, et seq., plus eventually plugging hole to KCC specifications.

Date 2/12/86 Signature of Operator or Agent Sheri Cholan Title as agent.....

For KCC Use:

Conductor Pipe Required feet; Minimum Surface Pipe Required 20 feet per Alt. X 2

This Authorization Expires 8-12-86 Approved By 2-12-86


Handwritten signature and initials

Must be filed with the K.C.C. five (5) days prior to commencing well
 This card void if drilling not started within six (6) months of date received by K.C.C.

Important procedures to follow:

1. Notify District office before setting surface casing.
2. Set surface casing by circulating cement to the top.
3. File completion forms ACO-1 with K.C.C. within 90 days of well completion, following instructions on ACO-1, side 1, and including copies of wireline logs.
4. Notify District office 48 hours prior to old well workover or re-entry.
5. Prior to filing Intent, prepare a proposed plugging plan in case well is D & A, then obtain approval of plan when calling district office prior to setting surface pipe.
6. Submit plugging report (CP-4) to K.C.C. after plugging is completed.
7. Obtain an approved injection docket number before disposing of salt water.
8. Notify K.C.C. within 10 days when injection commences or terminates.
9. If an alternate 2 completion, cement in the production pipe from below any usable water to surface within 120 days of spud date.

A Regular Section of Land
1 Mile = 5,280 Ft.

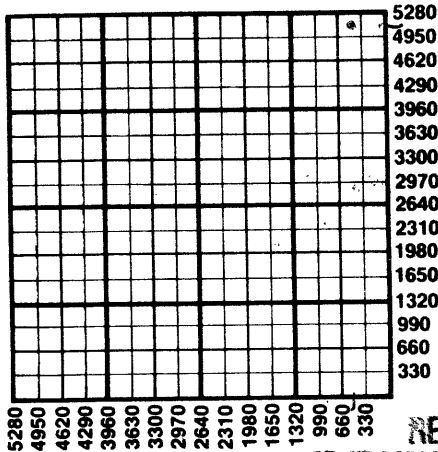

RECEIVED

STATE CORPORATION COMMISSION

FEB 12 1986

CONSERVATION DIVISION
 Wichita, Kansas

State Corporation Commission of Kansas
 Conservation Division
 200 Colorado Derby Building
 Wichita, Kansas 67202
 (316) 263-3238