

CARD MUST BE TYPED

State of Kansas
NOTICE OF INTENTION TO DRILL
(see rules on reverse side)

CARD MUST BE SIGNED

Starting Date: 11 30 84
month day year 11:00

API Number 15- 121-26,449-00-00

OPERATOR: License # 5304
Name ... Gault Energy Corporation
Address ... Box 516 616 E. Main
City/State/Zip ... Gardner, KS 66030
Contact Person ... Ross Gault
Phone ... 913 884 7510

..... SW/4 ... Sec . 26 Twp . 15 S, Rge . 21. East
(location) West

..... 1400 Ft North from Southeast Corner of Section
..... 4180 Ft West from Southeast Corner of Section
(Note: Locate well on Section Plat on reverse side)

CONTRACTOR: License #
Name ... Company Tools
City/State

Nearest lease or unit boundary line ... 1100 feet.
County ... Miami
Lease Name ... Lamberth Well# ... 1

Domestic well within 330 feet : yes no
Municipal well within one mile : yes no

Well Drilled For: **Well Class:** **Type Equipment:**
 Oil Swd Infield Mud Rotary
 Gas Inj Pool Ext. Air Rotary
 OWWO Expl Wildcat Cable

Depth to Bottom of fresh water 25 feet
Lowest usable water formation ... Kansas City Group
Depth to Bottom of usable water 300 feet
Surface pipe by Alternate : 1 2
Surface pipe to be set 20 feet
Conductor pipe if any required feet
Ground surface elevation feet MSL

This Authorization Expires ... 5-30-85
Approved By ... 11-30-84 *R*

If OWWO: old well info as follows:

Operator
Well Name
Comp Date Old Total Depth
Projected Total Depth 800 feet
Projected Formation at TD Squirrel
Expected Producing Formations

I certify that we will comply with K.S.A. 55-101, et seq., plus eventually plugging hole to K.C.C. specifications.

Date 11-30-84 Signature of Operator or Agent

Raquel Robles

Title As. agent


MHC/KOHE 11/30/84

**Must be filed with the K.C.C. five (5) days prior to commencing well
 This card void if drilling not started within six (6) months of date received by K.C.C.**

WICHITA, KANSAS
 CONSERVATION DIVISION

NOV 30 1984

A Regular Well Completion Report
 1 Mile

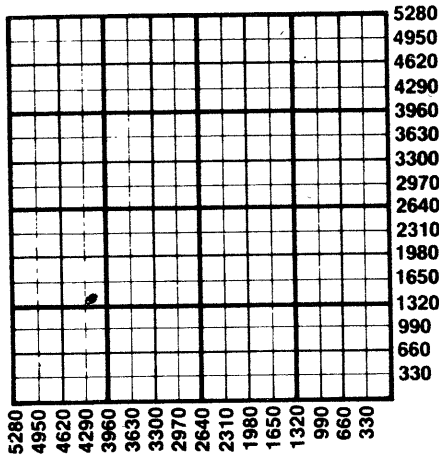

Important procedures to follow:

1. Notify District office before setting surface casing.
2. Set surface casing by circulating cement to the top.
3. File completion forms ACO-1 with K.C.C. within 90 days of well completion, following instructions on ACO-1, side 1, and including copies of wireline logs.
4. Notify District office 48 hours prior to old well workover or re-entry.
5. Prior to plugging, prepare a plugging plan, then obtain agreement from the appropriate district office for an approved plugging plan.
6. Submit plugging report (CP-4) to K.C.C. after plugging is completed.
7. Obtain an approved injection docket number before disposing of salt water.
8. Notify K.C.C. within 10 days when injection commences or terminates.
9. If an alternate 2 completion, cement in the production pipe from below any usable water to surface within 120 days of spud date.

**State Corporation Commission of Kansas
 Conservation Division
 200 Colorado Derby Building
 Wichita, Kansas 67202
 (316) 263-3238**