

STATE OF KANSAS
STATE CORPORATION COMMISSION

Form CP-4


Give All Information Completely
Make Required Affidavit
Mail or Deliver Report to:
Conservation Division
State Corporation Commission
212 No. Market
Wichita, Kansas

WELL PLUGGING RECORD

GRAHAM County. Sec. 34 Twp. 7 Rge. 24W (E) (W)

Location as "NE/CNW/SW" or footage from lines NE SW SW
Lease Owner C-G DRILLING CO.
Lease Name CHARLES Well No. 1
Office Address 1107 UNION NATIONAL BLDG., WICHITA, KS 67202
Character of Well (completed as Oil, Gas or Dry Hole) DRY HOLE
Date well completed AUGUST 3 19 70
Application for plugging filed AUGUST 3 19 70
Application for plugging approved AUGUST 3 19 70
Plugging commenced AUGUST 3 19 70
Plugging completed AUGUST 3 19 70
Reason for abandonment of well or producing formation TOO LOW STRUCTURALLY

NORTH

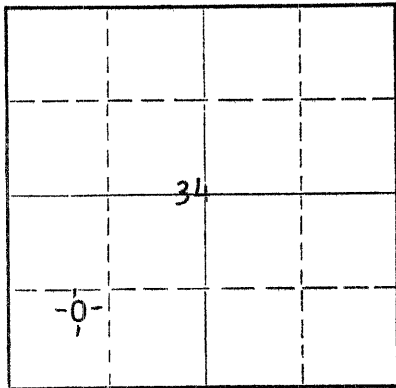

Locate well correctly on above Section Plat

If a producing well is abandoned, date of last production _____ 19 ____
Was permission obtained from the Conservation Division or its agents before plugging was commenced? YES

Name of Conservation Agent who supervised plugging of this well W. L. NICHOLS
Producing formation _____ Depth to top _____ Bottom _____ Total Depth of Well 3810 Feet
Show depth and thickness of all water, oil and gas formations.

OIL, GAS OR WATER RECORDS

CASING RECORD

FORMATION	CONTENT	FROM	TO	SIZE	PUT IN	PULLED OUT
				8-5/8"	212.33	NONE

Describe in detail the manner in which the well was plugged, indicating where the mud fluid was placed and the method or methods used in introducing it into the hole. If cement or other plugs were used, state the character of same and depth placed, from _____ feet to _____ feet for each plug set.

FILLED WITH HEAVY MUD TO 1125'. SET PLUG. PUT IN 100 SACKS CEMENT. FILLED WITH HEAVY MUD TO 240'. SET PLUG. PUT IN 25 SACKS CEMENT. FILLED WITH HEAVY MUD UP TO 40'. SET PLUG. PUT IN 10 SACKS CEMENT.

RECEIVED
STATE CORPORATION COMMISSION
AUG 11 1970
CONSERVATION DIVISION
Wichita, Kansas

(If additional description is necessary, use BACK of this sheet)
Name of Plugging Contractor C-G DRILLING CO.
Address 1107 UNION NATIONAL BLDG. WICHITA, KANSAS 67202

STATE OF KANSAS COUNTY OF SEDGWICK, ss.
G. F. GALLOWAY (employee of owner) or (owner or operator) of the above-described well, being first duly sworn on oath, says: That I have knowledge of the facts, statements, and matters herein contained and the log of the above-described well as filed and that the same are true and correct. So help me God.

(Signature) G. F. Galloway
107 Union National Bldg.
(Address)

Subscribed and sworn to before me this 5th day of August, 19 70

My commission expires December 7, 1971

Phyllis Buchanan
Phyllis Buchanan
Notary Public.

