

15-179-00101-00-00


STATE OF KANSAS
STATE CORPORATION COMMISSION

WELL PLUGGING RECORD

Give All Information Completely
Make Required Affidavit
Mail or Deliver Report to:
Conservation Division
State Corporation Commission
800 Bittling Building
Wichita, Kansas

Sheridan County, Sec. 34 Twp. 6S Rge. 28W (E) (W)

Location as "NE/CNW%SW%" or footage from lines NW NW NW
Lease Owner Coppinger Drlg., Inc.
Lease Name Wagoner Well No. 1
Office Address 320 Union Nat'l Bank Bldg., Wichita, Kansas.
Character of Well (completed as Oil, Gas or Dry Hole) Dry Hole
Date well completed 11-4 1955
Application for plugging filed 11-4 1955
Application for plugging approved 11-4 1955
Plugging commenced 11-4 1955
Plugging completed 11-4 1955
Reason for abandonment of well or producing formation Dry

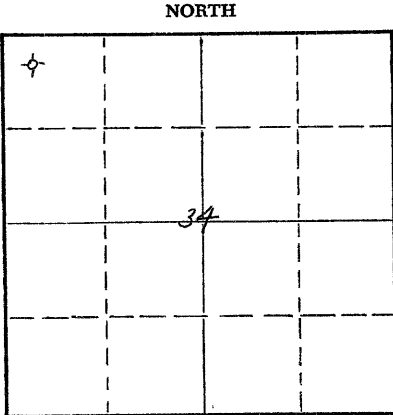

Locate well correctly on above Section Plat

If a producing well is abandoned, date of last production 19
Was permission obtained from the Conservation Division or its agents before plugging was commenced? Yes

Name of Conservation Agent who supervised plugging of this well Eldon Peddy, Hays, Kansas.
Producing formation _____ Depth to top _____ Bottom _____ Total Depth of Well 4661 Feet
Show depth and thickness of all water, oil and gas formations.

OIL, GAS OR WATER RECORDS

CASING RECORD

FORMATION	CONTENT	FROM	TO	SIZE	PUT IN	PULLED OUT
				8-5/8"	385	-0-

Describe in detail the manner in which the well was plugged, indicating where the mud fluid was placed and the method or methods used in introducing it into the hole. If cement or other plugs were used, state the character of same and depth placed, from _____ feet to _____ feet for each plug set.

Filled hole with mud laden fluid to 375 feet of top.
Pushed plug to 375 feet
Cemented with 15 sacks
Filled hole with mud to 40 feet of top
Pushed plug to 40 feet
Cemented with 10 sacks.

11-10-55

(If additional description is necessary, use BACK of this sheet)
Name of Plugging Contractor Coppinger Drilling, Inc.
Address 320 Union National Bank Bldg., Wichita, Kansas.

STATE OF KANSAS, COUNTY OF SEDGWICK, ss.
Lee Poulsen (employee of owner) or ~~owner or operator~~ of the above-described well, being first duly sworn on oath, says: That I have knowledge of the facts, statements, and matters herein contained and the log of the above-described well as filed and that the same are true and correct. So help me God.

(Signature) Lee Poulsen
320 Union National Bank Bldg.
(Address)

SUBSCRIBED AND SWORN TO before me this 7th day of November, 1955

My commission expires March 7, 1956
Mayree Broadus Notary Public.

PLUGGING
NOV 10 1955
BOOK PAGE 15 LINE 5