


15-179-20155-00-00

STATE OF KANSAS  
STATE CORPORATION COMMISSION

Give All Information Completely  
Make Required Affidavit  
Mail or Deliver Report to:  
Conservation Division  
State Corporation Commission  
212 No. Market  
Wichita, Kansas

WELL PLUGGING RECORD

NORTH

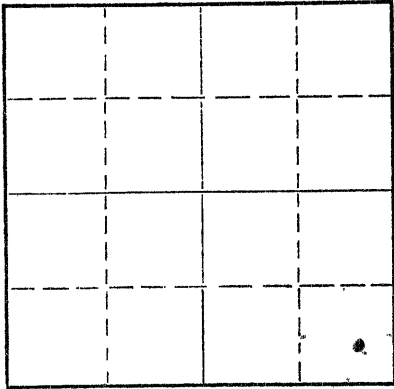

Locate well correctly on above  
Section Plat

Sheridan County, Sec. 6 Twp. 6S Rge. 28 (E) W (W)

Location as "NE/CNW/SW" or footage from lines 440' FSL 440' FEL

Lease Owner Petroleum Management, Inc.

Lease Name Trommeter Well No. 1

Office Address 1515 Wichita Plaza Building, Wichita, Kansas

Character of Well (completed as Oil, Gas or Dry Hole) D & A

Date well completed November 4, 1968

Application for plugging filed November 4, 1968

Application for plugging approved November 4, 1968

Plugging commenced November 4, 1968

Plugging completed November 4, 1968

Reason for abandonment of well or producing formation D & A

If a producing well is abandoned, date of last production 19

Was permission obtained from the Conservation Division or its agents before plugging was commenced? Yes

Name of Conservation Agent who supervised plugging of this well W. L. Nichols

Producing formation Depth to top Bottom Total Depth of Well 4230 Feet

Show depth and thickness of all water, oil and gas formations.

OIL, GAS OR WATER RECORDS

CASING RECORD

FORMATION	CONTENT	FROM	TO	SIZE	PUT IN	PULLED OUT
				8 5/8"	283.02'	-0-

Describe in detail the manner in which the well was plugged, indicating where the mud fluid was placed and the method or methods used in introducing it into the hole. If cement or other plugs were used, state the character of same and depth placed, from feet to feet for each plug set.

Set plug @ 1700'  
cemented with 100 sx  
50-50 poz 6% gel. Set  
plug @ 300' cemented  
w/ 20 sx 50-50 poz  
6% gel. Set plug @ 40'  
10 sx. 50-50 poz 6% gel

RECEIVED  
STATE CORPORATION COMMISSION  
NOV 12 1968  
CONSERVATION DIVISION  
Wichita, Kansas

11-12-68

(If additional description is necessary, use BACK of this sheet)

Name of Plugging Contractor Red Tiger Drilling Company

Address 1720 Wichita Plaza Building, Wichita, Kansas 67202

STATE OF Kansas, COUNTY OF Sedgwick, ss.

Norman E. Klein (employee of owner) or (owner or operator) of the above-described well, being first duly sworn on oath, says: That I have knowledge of the facts, statements, and matters herein contained and the log of the above-described well as filed and that the same are true and correct. So help me God.

(Signature) Norman E. Klein

1720 Wichita Plaza, Wichita, Kansas (Address)

Subscribed and Sworn to before me this 7th day of November, 1968

My commission expires September 9, 1969

Almeda Day

Notary Public.

