


Give All Information Completely  
Make Required Affidavit  
Mail or Deliver Report to:  
Conservation Division  
State Corporation Commission  
211 No. Broadway  
Wichita, Kansas

WELL PLUGGING RECORD

NORTH

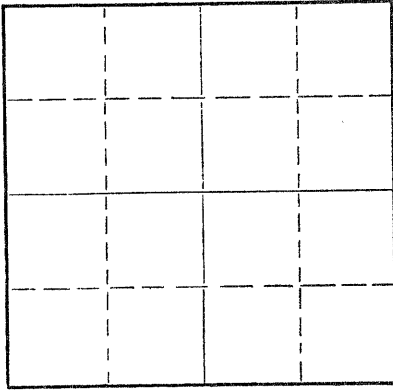

Locate well correctly on above Section Plat

Sheridan County. Sec. 26 Twp. 6S Rge. 30 (E) W (W)  
Location as "NE/CNW/SW" or footage from lines. C SE NE  
Lease Owner Tom Kat, Inc.  
Lease Name Farber Well No. 1  
Office Address 1125 Wichita Plaza, Wichita, Kansas  
Character of Well (completed as Oil, Gas or Dry Hole) D & A  
Date well completed July 17, 19 65  
Application for plugging filed 19  
Application for plugging approved 19  
Plugging commenced July 17, 19 65  
Plugging completed July 17, 19 65  
Reason for abandonment of well or producing formation No commercial quantities of oil or gas encountered.  
If a producing well is abandoned, date of last production 19  
Was permission obtained from the Conservation Division or its agents before plugging was commenced?

Name of Conservation Agent who supervised plugging of this well W. H. Nichols, Morland, Kansas  
Producing formation \_\_\_\_\_ Depth to top \_\_\_\_\_ Bottom \_\_\_\_\_ Total Depth of Well 4655 Feet  
Show depth and thickness of all water, oil and gas formations.

OIL, GAS OR WATER RECORDS

CASING RECORD

FORMATION	CONTENT	FROM	TO	SIZE	PUT IN	PULLED OUT
				8 5/8"	209'	None

Describe in detail the manner in which the well was plugged, indicating where the mud fluid was placed and the method or methods used in introducing it into the hole. If cement or other plugs were used, state the character of same and depth placed, from \_\_\_\_\_ feet to \_\_\_\_\_ feet for each plug set.

Heavy mud was put into the hole to a depth of 550 feet, where the bottom plug was set and cemented with 20 sacks of cement. Mud was then put into the hole to a depth of 200 feet, where the middle plug was set and cemented with 20 sacks of cement. Mud was again put into the hole to a depth of 40 feet, where the top plug was set and cemented with 10 sacks of cement.

Surface casing was cut off below ground level and the location abandoned.

RECEIVED  
STATE CORPORATION COMMISSION  
JUL 26 1965  
CONSERVATION DIVISION  
Wichita, Kansas

(If additional description is necessary, use BACK of this sheet)  
Name of Plugging Contractor Tom Kat, Inc.  
Address 1125 Wichita Plaza, Wichita, Kansas

7-26-65

STATE OF KANSAS, COUNTY OF SEDGWICK, ss.  
Richard C. Davis (employee of owner) or (owner or operator) of the above-described well, being first duly sworn on oath, says: That I have knowledge of the facts, statements, and matters herein contained and the log of the above-described well as filed and that the same are true and correct. So help me God.

(Signature) *[Signature]*  
1125 Wichita Plaza, Wichita, Kansas  
(Address)

SUBSCRIBED AND SWORN TO before me this 21st day of July, 19 65.

My commission expires January 19, 1969.

*[Signature]*  
Notary Public.