

KANSAS CORPORATION COMMISSION  
OIL & GAS CONSERVATION DIVISION  
**WELL PLUGGING APPLICATION**  
Please TYPE Form and File ONE Copy

RECEIVED  
AUG 08 2005  
KCC WICHITA

Form CP-1  
September 2003  
This Form must be Typed  
Form must be Signed  
Blanks must be Filled

API # 15-119-21137-00-00 (Identifier Number of this well). This must be listed for wells drilled since 1967; if no API # was issued, indicate original spud or completion date 7/5/05 (completion-waiting on pluggers)

Well Operator: Midwestern Exploration Co. KCC License #: 5263  
(Owner / Company Name) (Operator's)

Address: 3500 S. Boulevard, Suite 2B City: Edmond

State: Oklahoma Zip Code: 73013 Contact Phone: (405) 340-4300

Lease: Shank Well #: 1-14 Sec. 14 Twp. 32 S. R. 30  East  West

C - S/2 - NE/4 Spot Location / QQQQ County: Meade

1980 Feet (in exact footage) From  North /  South (from nearest outside section corner) Line of Section (Not Lease Line)

1320 Feet (in exact footage) From  East /  West (from nearest outside section corner) Line of Section (Not Lease Line)

Check One:  Oil Well  Gas Well  D&A  Cathodic  Water Supply Well  
 SWD Docket # \_\_\_\_\_  ENHR Docket # \_\_\_\_\_  Other: \_\_\_\_\_

Conductor Casing Size: none Set at: \_\_\_\_\_ Cemented with: \_\_\_\_\_ Sacks

Surface Casing Size: 8 5/8 - 24# Set at: 1648' Cemented with: 625 Sacks

Production Casing Size: 4 1/2" - 10.5# Set at: GL to 2133' Cemented with: 160 Sacks

List (ALL) Perforations and Bridgeplug Sets: 4 1/2" - 11.6# 2134 to 3400'  
Perf. 3052-63' w/4 spf. Perf. 3206-10' w/4 spf. CIBP @ 3150' w/cmt on top.

Perf 3052-63' w/4 spf.

Elevation: 2751' ( G.L. /  K.B.) T.D.: 3895' P.B.T.D.: 3380' Anhydrite Depth: Approx. 1650'  
(Stone Corral Formation)

Condition of Well:  Good  Poor  Casing Leak  Junk in Hole

Proposed Method of Plugging (attach a separate page if additional space is needed):

Per KCC instructions.

Is Well Log attached to this application as required?  Yes  No Is ACO-1 filed?  Yes  No

If not explain why? Waiting on pluggers.

Plugging of this Well will be done in accordance with K.S.A. 55-101 et. seq. and the Rules and Regulations of the State Corporation Commission.

List Name of Company Representative authorized to be in charge of plugging operations: Billy Daugherty, Field Foreman

Phone: (620) 629-5710

Address: 1800 N. Cain Ave. City / State: Liberal, Kansas 67901

Plugging Contractor: Eagle Services, Inc. KCC License #: 7407  
(Company Name) (Contractor's)

Address: P. O. Box 1597 Phone: (620) 624-1904

Proposed Date and Hour of Plugging (if known?): September 1, 2005

Payment of the Plugging Fee (K.A.R. 82-3-118) will be guaranteed by Operator or Agent  
Date: 8/4/05 Authorized Operator Agent: Dale J. Lollar  
(Signature)

Mail to: KCC - Conservation Division, 130 S. Market - Room 2078, Wichita, Kansas 67202

6/06


6/06

# SHANK 1-14

1980' FNL ~ 1320' FEL  
SECTION 14 - T32S - R30W  
MEADE Co., KANSAS

ELEV  
GROUND 2741  
KB 2751

8 5/8" Surface PIPE SA 1648  
24# w/625SX

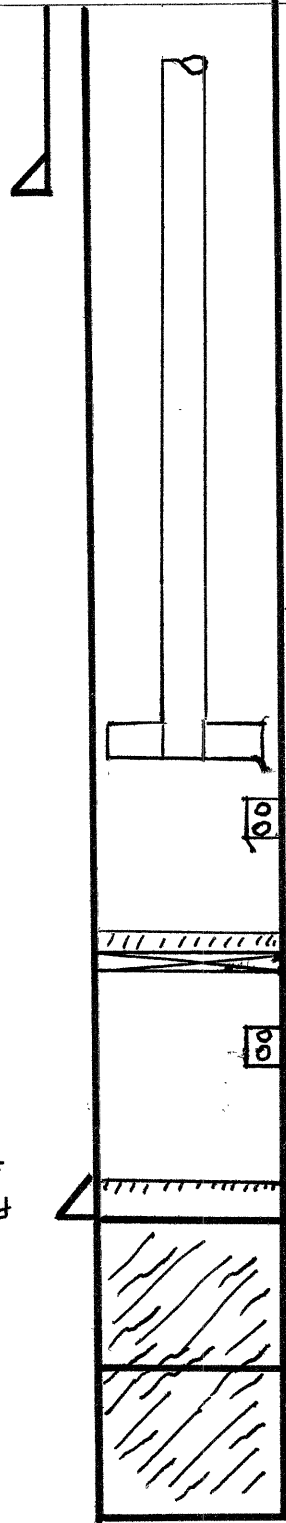

TOP OF CEMENT 2635'

2 3/8 Tbg w/ 4 1/2 x 2 3/8" Packer  
Swinging @ 3005'

WREFORD PERFS 3052-62

CIBP @ 3150' w/ CMT ON TOP

COUNCIL GROVE PERFS 3206-10

Plug back Total Depth 3380'

4 1/2" CSQ SA 3400' w/ 160SX

TOP CEMENT PLUG 3400'

TOTAL DEPTH 3895'

4 1/2" CSQ string  
3400 + 2134 - 11.6#  
2133 - GL - 10.5#

42,381 50 SHEETS 5 SQUARE  
42,382 100 SHEETS 5 SQUARE  
42,389 200 SHEETS 5 SQUARE  
NATIONAL

RECEIVED  
AUG 08 2006  
KCC WICHITA

KANSAS

CORPORATION COMMISSION

Kathleen Sebelius, Governor    Brian J. Moline, Chair    Robert E. Krehbiel, Commissioner    Michael C. Moffet, Commissioner

**NOTICE OF RECEIPT OF WELL PLUGGING APPLICATION (CP-1)**

Midwestern Exploration Company  
3500 S Boulevard - Suite 2B  
Edmond, OK 73013

August 08, 2005

Re: SHANK #1-14  
API 15-119-21137-00-00  
S2NE 14-32S-30W, 1980 FNL 1320 FEL  
MEADE COUNTY, KANSAS

Dear Operator:

This letter is to notify you that the Conservation Division is in receipt of your plugging proposal, form CP-1, for the above-captioned well.

Your CP-1 has been reviewed by the Conservation Division central office for completeness and to verify license numbers. The plugging proposal will now be forwarded to the district office listed below for review of your proposed method of plugging.

**Please contact the district office for approval of your proposed plugging method at least five (5) days before plugging the well, pursuant to K.A.R. 82-3-113 (b). If a workover pit will be used during the plugging of the well it must be permitted. A CDP-1 form must be filed and approved prior to the use of the pit.**

The Conservation Division's review of form CP-1, either in the central or district office, does not include an inquiry into well ownership or the filing operator's legal right to plug the well.

**This notice in no way constitutes authorization to plug the above-captioned well by persons not having legal rights of ownership or interest in the well. This notice is void after ninety (90) days from the above date.**

District: #1  
210 E Frontview, Suite A  
Dodge City, KS 67801  
(620) 225-8888

Sincerely



David P. Williams  
Production Supervisor