

For KCC Use: Effective Date: 8-30-05 District #: 3 SGA?  Yes  No

KANSAS CORPORATION COMMISSION OIL & GAS CONSERVATION DIVISION NOTICE OF INTENT TO DRILL

Form C-1 December 2002 Form must be Typed Form must be Signed All blanks must be Filled

Must be approved by KCC five (5) days prior to commencing well

Expected Spud Date August 31, 2005 month day year

AP. NW-NE-SE

Spot E/2 - E/2 - SW Sec. 15 Twp. 27S S. R. 22E  East  West

OPERATOR: License# 33428 Name: Fort Scott Methane Partners, LLC Address: 5513 Golf Course Drive City/State/Zip: Morrison, CO 80465 Contact Person: Larry Weis Phone: 303-895-7178

1200 feet from  N /  S Line of Section 2200 feet from  E /  W Line of Section Is SECTION  Regular  Irregular?

CONTRACTOR: License# 5831 Name: Mokat Drilling

(Note: Locate well on the Section Plat on reverse side) County: Bourbon Lease Name: Garrett Well #: 15-24 Field Name: Wildcat

Well Drilled For:  Oil  Gas  OAWO  Seismic; # of Holes  Other CBM Well Class:  Enh Rec  Storage  Disposal  Other Type Equipment:  Infield  Pool Ext.  Wildcat  Other  Mud Rotary  Air Rotary  Cable

Is this a Prorated / Spaced Field?  Yes  No Target Formation(s): Cherokee Coals Nearest Lease or unit boundary: 440' Ground Surface Elevation: 966 feet MSL Water well within one-quarter mile:  Yes  No Public water supply well within one mile:  Yes  No Depth to bottom of fresh water: 100'+ Depth to bottom of usable water: 200'+ Surface Pipe by Alternate:  1  2 Length of Surface Pipe Planned to be set: 20' minimum Length of Conductor Pipe required: None Projected Total Depth: 750' Formation at Total Depth: Mississippian Water Source for Drilling Operations:  Well  Farm Pond Other          DWR Permit #:          (Note: Apply for Permit with DWR ) Will Cores be taken?  Yes  No If Yes, proposed zone:         

If OWWO: old well information as follows: Operator:          Well Name:          Original Completion Date:          Original Total Depth:         

Directional, Deviated or Horizontal wellbore?  Yes  No If Yes, true vertical depth:          Bottom Hole Location:          KCC DKT #:         

AFFIDAVIT

The undersigned hereby affirms that the drilling, completion and eventual plugging of this well will comply with K.S.A. 55 et. seq. It is agreed that the following minimum requirements will be met:

RECEIVED KANSAS CORPORATION COMMISSION AUG 24 2005 CONSERVATION DIVISION WICHITA, KS

- 1. Notify the appropriate district office prior to spudding of well;
2. A copy of the approved notice of intent to drill shall be posted on each drilling rig;
3. The minimum amount of surface pipe as specified below shall be set by circulating cement to the top; in all cases surface pipe shall be set through all unconsolidated materials plus a minimum of 20 feet into the underlying formation.
4. If the well is dry hole, an agreement between the operator and the district office on plug length and placement is necessary prior to plugging;
5. The appropriate district office will be notified before well is either plugged or production casing is cemented in;
6. If an ALTERNATE II COMPLETION, production pipe shall be cemented from below any usable water to surface within 120 days of spud date. Or pursuant to Appendix "B" - Eastern Kansas surface casing order #133,891-C, which applies to the KCC District 3 area, alternate II cementing must be completed within 30 days of the spud date or the well shall be plugged. In all cases, NOTIFY district office prior to any cementing.

I hereby certify that the statements made herein are true and to the best of my knowledge and belief.

Date: 8-22-05 Signature of Operator or Agent: [Signature] Title: Agent

For KCC Use ONLY API # 15 - 011-23139-00-00 Conductor pipe required NONE feet Minimum surface pipe required 20' feet per Alt. X(2) Approved by: DPW 8-25-05 This authorization expires: 2-25-06 (This authorization void if drilling not started within 6 months of effective date.) Spud date:          Agent:         

- Remember to: - File Drill Pit Application (form CDP-1) with Intent to Drill; - File Completion Form ACO-1 within 120 days of spud date; - File acreage attribution plat according to field proration orders; - Notify appropriate district office 48 hours prior to workover or re-entry; - Submit plugging report (CP-4) after plugging is completed; - Obtain written approval before disposing or injecting salt water. - If this permit has expired (See: authorized expiration date) please check the box below and return to the address below. [ ] Well Not Drilled - Permit Expired Signature of Operator or Agent:          Date:

Mail to: KCC - Conservation Division, 130 S. Market - Room 2078, Wichita, Kansas 67202

15 27 226

**IN ALL CASES PLOT THE INTENDED WELL ON THE PLAT BELOW**

*Plat of acreage attributable to a well in a prorated or spaced field*

**If the intended well is in a prorated or spaced field, please fully complete this side of the form.** If the intended well is in a prorated or spaced field complete the plat below showing that the well will be properly located in relationship to other wells producing from the common source of supply. Please show all the wells and within 1 mile of the boundaries of the proposed acreage attribution unit for gas wells and within 1/2 mile of the boundaries of the proposed acreage attribution unit for oil wells.

API No. 15 - 011-231390000  
 Operator: Fort Scott Methane Partners, LLC  
 Lease: Garrett  
 Well Number: 15-24  
 Field: Wildcat  
 Number of Acres attributable to well: \_\_\_\_\_  
 QTR / QTR / QTR of acreage: E/2 - E/2 - SW



Location of Well: County: Bourbon  
1200 feet from  N /  S Line of Section  
2200 feet from  E /  W Line of Section  
 Sec. 15 Twp. 27S S. R. 22E  East  West

Is Section:  Regular or  Irregular

**If Section is irregular, locate well from nearest corner boundary.**  
 Section corner used:  NE  NW  SE  SW

**PLAT**

*(Show location of the well and shade attributable acreage for prorated or spaced wells.)  
 (Show footage to the nearest lease or unit boundary line.)*

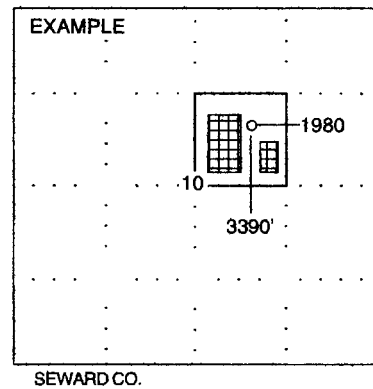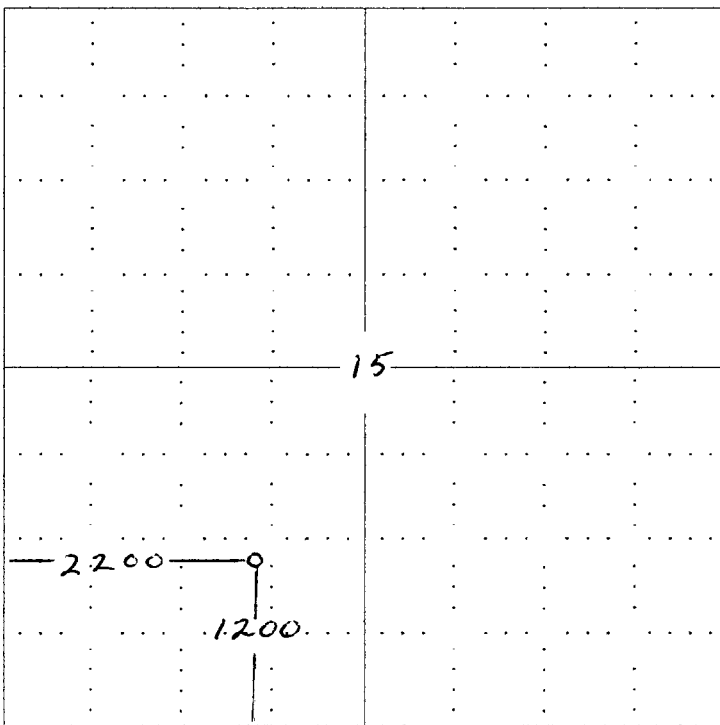

**NOTE: In all cases locate the spot of the proposed drilling locaton.**

**In plotting the proposed location of the well, you must show:**

1. The manner in which you are using the depicted plat by identifying section lines, i.e. 1 section, 1 section with 8 surrounding sections, 4 sections, etc.
2. The distance of the proposed drilling location from the section's south / north and east / west.
3. The distance to the nearest lease or unit boundary line.
4. If proposed location is located within a prorated or spaced field a certificate of acreage attribution plat must be attached: (C0-7 for oil wells; CG-8 for gas wells).