

For KCC Use:
 Effective Date: 8-28-05
 District #: 2
 SGA? Yes No

KANSAS CORPORATION COMMISSION
 OIL & GAS CONSERVATION DIVISION
NOTICE OF INTENT TO DRILL

Form C-1
 December 2002
 Form must be Typed
 Form must be Signed
 All blanks must be Filled

Must be approved by KCC five (5) days prior to commencing well

E/2 NW SE SW

Expected Spud Date August 22 2006
month day year

Spot
 S. R. 9a SW Sec. 18 Twp. 30s S. R. 9 East West
~~990~~ 990' feet from N / S Line of Section
~~1710~~ 1710' feet from E / W Line of Section
 Is SECTION Regular Irregular?

OPERATOR: License# 30717 ✓
 Name: Downing-Nelson Oil Co., Inc.
 Address: POB 372
Hays, Ks. 67601
 City/State/Zip:
 Contact Person: Alan Downing
 Phone: 785-621-2610

(Note: Locate well on the Section Plat on reverse side)
 County: Kingman
 Lease Name: Hawley Well #: 2-15
 Field Name: Spivey-Grabbs

CONTRACTOR: License# 33810 ✓
 Name: Fossil Drilling Co.

Is this a Prorated / Spaced Field? Yes No
 Target Formation(s): Miss

Well Drilled For: Oil Gas OWWO Saline/ Other
 Well Glass: Enh Rec Storage Disposal # of Holes Other
 Well Class: Infield Pool Ext. Wildcat Other
 Type Equipment: Muc Rotary Air Rotary Cable

Nearest Lease or unit boundary: 890' 990'
 Ground Surface Elevation: 1885' feet MSL
 Water well within one-quarter mile: Yes No
 Public water supply well within one mile: Yes No
 Depth to bottom of fresh water: 120'
 Depth to bottom of usable water: 180'
 Surface Pipe by Alternates: 1 2

If OWWO: old well information as follows:
 Operator: _____
 Well Name: _____
 Original Completion Date: _____ Original Total Depth: _____

Length of Surface Pipe Planned to be set: 200'
 Length of Conductor Pipe required: none
 Projected Total Depth: 4400'
 Formation at Total Depth: Viola
 Water Source for Drilling Operations:
 Well Farm Pond Other

Directional, Deviated or Horizontal wellbore? Yes No
 If Yes, true vertical depth: _____
 Bottom Hole Location: KANSAS CORPORATION COMMISSION
 KCC DKT #: _____

DWR Permit #: Applied for
 (Note: Apply for Permit with DWR)
 Will Cores be taken? Yes No
 If Yes, proposed zone: _____

AUG 22 2005

AFFIDAVIT

The undersigned hereby affirms that the drilling, completion and eventual plugging of this well will comply with K.S.A. 55 et. seq.
 It is agreed that the following minimum requirements will be met:

1. Notify the appropriate district office prior to spudding of well;
2. A copy of the approved notice of intent to drill shall be posted on each drilling rig;
3. The minimum amount of surface pipe as specified below shall be set by circulating cement to the top; in all cases surface pipe shall be set through all unconsolidated materials plus a minimum of 20 feet into the underlying formation.
4. If the well is dry hole, an agreement between the operator and the district office on plug length and placement is necessary prior to plugging;
5. The appropriate district office will be notified before well is either plugged or production casing is cemented in;
6. If an ALTERNATE II COMPLETION, production pipe shall be cemented from below any usable water to surface within 120 days of spud date.
 Or pursuant to Appendix "B" - Eastern Kansas surface casing order #133,891-C, which applies to the KCC District 3 area, alternate II cementing must be completed within 30 days of the spud date or the well shall be plugged. In all cases, NOTIFY district office prior to any cementing.

I hereby certify that the statements made herein are true and to the best of my knowledge and belief.

Date: 8-21-06 Signature of Operator or Agent: _____ Title: CONTRACTOR

For KCC Use ONLY
 API # 15: 095-21982-00-00
 Conductor pipe required: NONE feet
 Minimum surface pipe required: 200' feet per Alt. 1 X
 Approved by: DPW 8-23-05
 This authorization expires: 2-23-06
 (This authorization void if drilling not started within 3 months of effective date.)
 Spud date: _____ Agent: _____

- Remember to:
- File Drill Pit Application (form CDP-1) with Intent to Drill;
 - File Completion Form ACO-1 within 120 days of spud date;
 - File storage attribution plat according to field prorated orders;
 - Notify appropriate district office 48 hours prior to workover or re-entry;
 - Submit plugging report (CP-4) after plugging is completed;
 - Obtain written approval before disposing or injecting salt water.
- If this permit has expired (See authorized expiration date) please check the box below and return to the address below.
 Well Not Drilled - Permit Expired
 Signature of Operator or Agent: _____
 Date: _____

Mail to: KCC - Conservation Division, 180 S. Market - Room 2078, Wichita, Kansas 67202

18 30 96

IN ALL CASES PLOT THE INTENDED WELL ON THE PLAT BELOW

Plat of acreage attributable to a well in a prorated or spaced field


If the intended well is in a prorated or spaced field, please fully complete this side of the form. If the intended well is in a prorated or spaced field complete the plat below showing that the well will be properly located in relationship to other wells producing from the common source of supply. Please show all the wells and within 1 mile of the boundaries of the proposed acreage attribution unit for gas wells and within 1/2 mile of the boundaries of the proposed acreage attribution unit for oil wells.

API No. 16 - 095 219820000
 Operator: Downing-Nelson Oil Co., Inc.
 Lease: Hawley
 Well Number: 2-18
 Field: Spivey-Grabbs
 Number of Acres attributable to well: _____
 QTR / QTR / QTR of acreage: SE - SW


Location of Well: County: Kingman
 980 _____ feet from N / S Line of Section
 1710 _____ feet from E / W Line of Section
 Sec. 16 Twp. 30s S. R. 9 East West
 Is Section: Regular or Irregular
 If Section is Irregular, locate well from nearest corner boundary.
 Section corner used: NE NW SE SW

PLAT

*(Show location of the well and shade attributable acreage for prorated or spaced wells.)
 (Show footage to the nearest lease or unit boundary line.)*

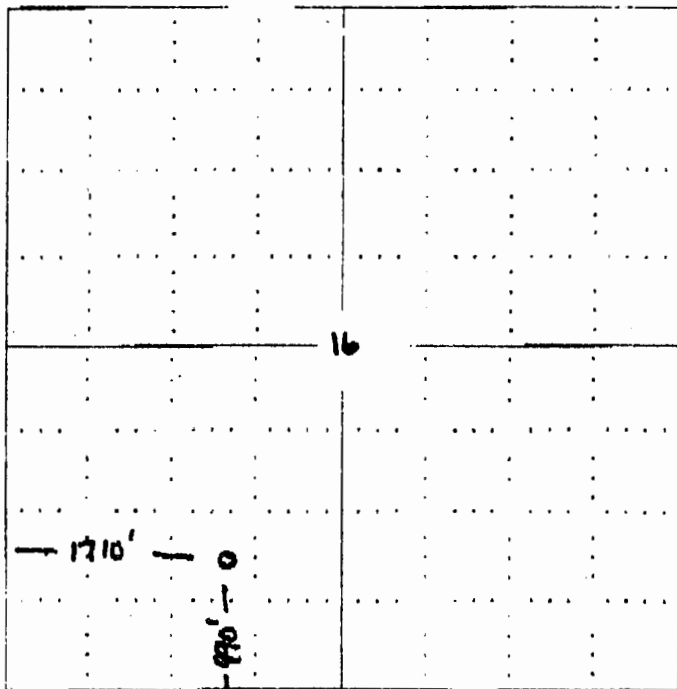

RECEIVED
 KANSAS CORPORATION COMMISSION
 AUG 22 2005
 CONSERVATION DIVISION
 WICHITA, KS

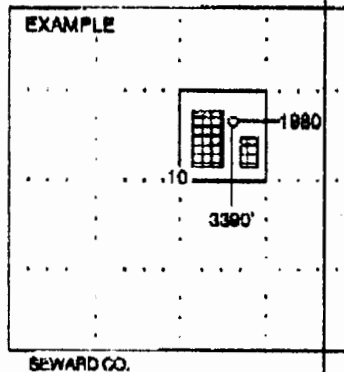

NOTE: In all cases locate the spot of the proposed drilling location.

In plotting the proposed location of the well, you must show:

1. The manner in which you are using the deploted plat by identifying section lines, i.e. 1 section, 1 section with 8 surrounding sections, 4 sections, etc.
2. The distance of the proposed drilling location from the section's south / north and east / west.
3. The distance to the nearest lease or unit boundary line.
4. If proposed location is located within a prorated or spaced field a certificate of acreage attribution plat must be attached: (CG-7 for oil wells; CG-8 for gas wells).

KANSAS

CORPORATION COMMISSION

KATHLEEN SEBELIUS, GOVERNOR
BRIAN J. MOLINE, CHAIR
ROBERT E. KREHBIEL, COMMISSIONER
MICHAEL C. MOFFET, COMMISSIONER

August 22, 2005

Mr. Alan Downing
Downing-Nelson Oil Co., Inc.
PO Box 372
Hays, KS 67601

Re: Drilling Pit Application
Hawley Lease Well No. 2-16
SW/4 Sec. 16-30S-09W
Kingman County, Kansas

Dear Mr. Downing:


District staff has inspected the above referenced location and has determined that the reserve pit shall be constructed **without slots**, the bottom shall be flat and reasonably level, and **all pits must be lined with bentonite**. The free fluids must be removed. The fluids are to be removed from the reserve pit as soon as the Hutchinson Salt section has been drilled through and displacement of the fluids into the reserve pit has occurred. The fluids should be removed again within 72 hours after drilling operations have ceased.

If production casing is set all completion fluids shall be removed on a daily basis.

The fluids should be taken to an authorized disposal well. Please call the District Office at (316) 630-4000 when the fluids have been removed. Please file form CDP-5, Exploration and Production Waste Transfer, within 30 days of fluid removal. Conservation division forms are available through our office and on the KCC web site: www.kcc.state.ks.us/conservation/forms.

A copy of this letter should be posted in the doghouse along with the approved Intent to Drill. If you have any questions or concerns please feel free to contact the undersigned at the above address.

Sincerely,

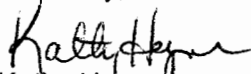

Kathy Haynes

Environmental Protection and Remediation Department

cc: Doug Louis