amended intent

CARD MUST BE TYPED

State of Kansas
NOTICE OF INTENTION TO DRILL
HUGOTON INFILL

CARD MUST BE SIGNED

CORRECTED

EFFECTIVE DATE 4-6-05

Starting Date AUGUST 22 2005 (month day year)

API Number 15- 187-21052-0000

IS SECTION X REGULAR ___ IRREGULAR

OPERATOR: License # 5952
Name BP AMERICA PRODUCTION COMPANY
Address P. O. BOX 3092, WL1, RM 3.201
City/State/Zip HOUSTON, TX 77253-3092
Contact Person DEANN SMYERS
Phone (281)366-4395

CONTRACTOR License # ~~5382~~ 33375
Name CHEYENNE DRILLING
City/State

Well Drilled as: X New ___ Recompletion ___ OWWO
Projected Total Depth 2600 feet
Formation
If OWWO or Recompletion: old well info as follows:
Operator
Well Name
Comp. Date Old Total Depth

NW NW SE SW Sec 23 Twp 29 S, Rg 40 W
1250 S Ft. from South Line of Section
1350 W Ft. from East Line of Section
Note: Attach acreage attribution plat locating both Chase (Hugoton) wells
Total number of acres attributed to unit 640
Nearest producing well from same common source of supply 1947 feet
Nearest lease or unit boundry line 1250 feet
County STANTON
Lease Name BENNETT Well # 3HI
Ground surface elevation 3252 feet MSL
Depth to bottom of fresh water 460
Depth to bottom of usable water 560
Surface pipe by Alternate: 1 X 2 ___
Surface pipe planned to be set 580 ALT-1
Water Source for Drilled Operations:
DWR Permit #: ___ well ___ farm pond X other

I certify that well will comply with K.S.A. 55-101, et seq., plus eventually plugging hole to KCC specifications.
Date AUGUST 18, 2005 Signature of Operator or Agent DeAnn Smyers Title REGULATORY STAFF ASSISTANT

WAS: ALT-2 480' ES: 560' ALT-1

For KCC Use:
Conductor Pipe Required NONE feet; Minimum Surface Pipe Required 580 feet per Alt (1) ~~2~~
This Authorization Expires 10-2-05 Approved By RJP 4-1-05/RJP 9-1-05

9/95

RECEIVED
KANSAS CORPORATION COMMISSION
AUG 19 2005
CONSERVATION DIVISION
WICHITA, KS

Must be filed with K.C.C. five (5) days prior to commencing well
This card void if drilling not started within six (6) months of date received by K.C.C.

A Regular Section of Land
1 Mile = 5,280 Ft.

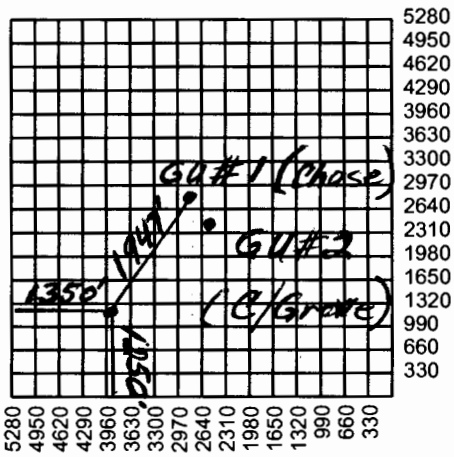

Important procedures to follow:
1. Notify District office before setting surface casing.
2. Set surface casing by circulating cement to the top.
3. File completion forms ACO-1 with K.C.C. within 120 days of well spud date, following instructions on ACO-1, side 1, and including copies of wireline logs.
4. Notify District office 48 hours prior to old well workover or re-entry.
5. Submit plugging report (CP-4) to K.C.C. after plugging is completed.
6. If an alternate 2 completion, cement in the production pipe from below any useable water to surface within 120 day of spud date.

State Corporation Commission of Kansas
Conservation Division
130 S. Market Room 2078
Wichita, Kansas 67202-1212
(316) 337-6231