

CARD MUST BE TYPED **KCC DIST #1**

AMENDED INTENT
State of Kansas
NOTICE OF INTENTION TO DRILL
HUGOTON INFILL

CARD MUST BE SIGNED

CORRECTED

EFFECTIVE DATE **4-6-05**

Starting Date **AUGUST 22 2005**
month day year

API Number 15-187-21051-0000

SGA - NO

IS SECTION REGULAR IRREGULAR

OPERATOR: License # **5952**
Name **BP AMERICA PRODUCTION COMPANY**
Address **P. O. BOX 3092, WL1, RM 3.201**
City/State/Zip **HOUSTON, TX 77253-3092**
Contact Person **DEANN SMYERS**
Phone **(281)366-4395**

SE NW NW Sec **13** Twp **30** S, Rg **40** W
1250 N Ft. from South Line of Section
1250 W Ft. from East Line of Section

Note: Attach acreage attribution plat locating both Chase (Hugoton) wells
Total number of acres attributed to unit **640**

CONTRACTOR License # **5382 33375**
Name **CHEYENNE DRILLING**
City/State

Nearest producing well from
same common source of supply **1947** feet
Nearest lease or unit boundary line **1250** feet

Well Drilled as: New Recompletion OWWO
Projected Total Depth **2600** feet
Formation

County **STANTON**
Lease Name **KOENIG B** Well # **5H1**
Ground surface elevation **3242** feet MSL

If OWWO or Recompletion: old well info as follows:
Operator
Well Name
Comp. Date Old Total Depth

Depth to bottom of fresh water **420**
Depth to bottom of usable water **540**
Surface pipe by Alternate: **1 X 2**
Surface pipe planned to be set **560' MIN**
Water Source for Drilled Operations:
DWR Permit #: well farm pond other

I certify that well will comply with K.S.A. 55-101, et seq., plus eventually plugging hole to KCC specifications.

Date **AUGUST 18, 2005** Signature of Operator or Agent *Deann Smyers* Title

REGULATORY STAFF

ASSISTANT

For KCC Use:
Conductor Pipe Required **NONE** feet; Minimum Surface Pipe Required **560** feet per Alt. **2**
This Authorization Expires **10-2-05**

***WAS: ALT-2 440' SURFACE PIPE IS: ALT-1 560' SURFACE**
Approved By **RSP 4-1-05 / RSP 9-1-05**

9/95


Must be filed with K.C.C. five (5) days prior to commencing well
This card void if drilling not started within six (6) months of date received by K.C.C.

RECEIVED
KANSAS CORPORATION COMMISSION

AUG 19 2005

CONSERVATION DIVISION
WICHITA, KS

A Regular Section of Land
1 Mile = 5,280 Ft.

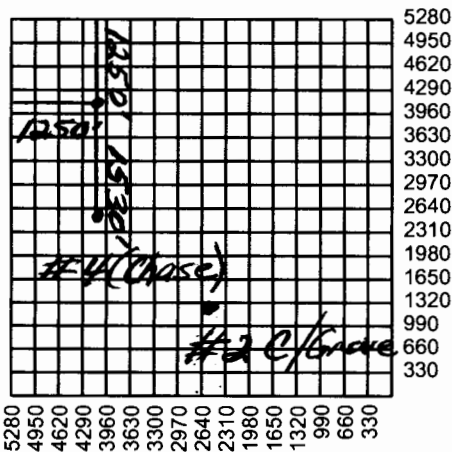

Important procedures to follow:

1. Notify District office before setting surface casing.
2. Set surface casing by circulating cement to the top.
3. File completion forms ACO-1 with K.C.C. within 120 days of well spud date, following instructions on ACO-1, side 1, and including copies of wireline logs.
4. Notify District office 48 hours prior to old well workover or re-entry.
5. Submit plugging report (CP-4) to K.C.C. after plugging is completed.
6. If an alternate 2 completion, cement in the production pipe from below any useable water to surface within 120 day of spud date.

State Corporation Commission of Kansas
Conservation Division
130 S. Market Room 2078
Wichita, Kansas 67202-1212
(316) 337-6231