

CARD MUST BE TYPED

State of Kansas
NOTICE OF INTENTION TO DRILL
(see rules on reverse side)

CARD MUST BE SIGNED

Starting Date: August 26, 1985
month day year

API Number 15- 179-20,844-00-00

OPERATOR: License # 5427
Name D. R. Lauck Oil Company, Inc.
Address 221 S. Broadway, Suite 400
City/State/Zip Wichita, Kansas 67202
Contact Person John D. Knightley
Phone (316) 263-8267

C E/2 W/2 SE Sec 9 Twp 6 S, Rge 29
(location) East West

1320 Ft North from Southeast Corner of Section
1650 Ft West from Southeast Corner of Section
(Note: Locate well on Section Plat on reverse side)

CONTRACTOR: License # 5427
Name D. R. Lauck Oil Company, Inc.
City/State Wichita, Kansas

Nearest lease or unit boundary line 990 feet.
County Sheridan

Lease Name Reed Parker Well# 1

Domestic well within 330 feet: yes no

Municipal well within one mile: yes no

Well Drilled For: Well Class: Type Equipment:
 Oil Swd Infield Mud Rotary
 Gas Inj Pool Ext. Air Rotary
 OWWO Expl Wildcat Cable

Depth to Bottom of fresh water 250 feet

Lowest usable water formation Ogallala

Depth to Bottom of usable water 250 feet

Surface pipe by Alternate: 1 ~~2~~

Surface pipe to be set 280 feet

Conductor pipe if any required

Ground surface elevation 2832 feet MSL

This Authorization Expires 2-23-86

Approved By RC4 8-23-85

If OWWO: old well info as follows:

Operator
Well Name
Comp Date Old Total Depth
Projected Total Depth 4250 feet
Projected Formation at TD Lansing-Kansas City
Expected Producing Formations Lansing-Kansas City

I certify that we will comply with K.S.A. 55-101, et seq., plus eventually plugging hole to K.C.C. specifications.

Date 8-21-85 Signature of Operator or Agent

D. R. Lauck Oil Company, Inc.

By: *John D. Knightley* Title

President

John D. Knightley


Must be filed with the K.C.C. five (5) days prior to commencing well
This card void if drilling not started within six (6) months of date received by K.C.C.

RECEIVED
AUG 27 1985
STATE CORPORATION COMMISSION CONSERVATION DIVISION

8-23-85

Important procedures to follow:

**A Regular Section of Land
1 Mile = 5,280 Ft.**

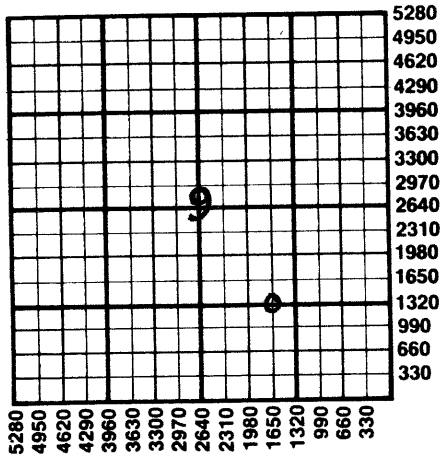

1. Notify District office before setting surface casing.
2. Set surface casing by circulating cement to the top.
3. File completion forms ACO-1 with K.C.C. within 90 days of well completion, following instructions on ACO-1, side 1, and including copies of wireline logs.
4. Notify District office 48 hours prior to old well workover or re-entry.
5. Prior to plugging, prepare a plugging plan, then obtain agreement from the appropriate district office for an approved plugging plan.
6. Submit plugging report (CP-4) to K.C.C. after plugging is completed.
7. Obtain an approved injection docket number before disposing of salt water.
8. Notify K.C.C. within 10 days when injection commences or terminates.
9. If an alternate 2 completion, cement in the production pipe from below any usable water to surface within 120 days of spud date.

**State Corporation Commission of Kansas
Conservation Division
200 Colorado Derby Building
Wichita, Kansas 67202
(316)263-3238**