

15-179-05230-00-00

STATE OF KANSAS
STATE CORPORATION COMMISSION

Give All Information Completely
Make Required Affidavit
Mail or Deliver Report to:
Conservation Division
State Corporation Commission
212 North Market, Insurance Bldg.
Wichita, Kansas

WELL PLUGGING RECORD

Sheridan County. Sec. 22 Twp. 6 Rge. 29 (E) (W)

Location as "NE/CNW $\frac{1}{4}$ SW $\frac{1}{4}$ " or footage from lines NE SW SW

Lease Owner Drillers-Producers Pipe & Supply Co., Inc.

Lease Name L. H. Wessel Well No. 3

Office Address Box 368, Great Bend, Kansas

Character of Well (completed as Oil, Gas or Dry Hole) oil

Date well completed _____ 19__

Application for plugging filed September 10, 1959 19__

Application for plugging approved September 11, 1959 19__


Plugging commenced September 19, 1959 19__

Plugging completed September 22, 1959 19__

Reason for abandonment of well or producing formation dry

If a producing well is abandoned, date of last production _____ 19__

Was permission obtained from the Conservation Division or its agents before plugging was commenced? yes

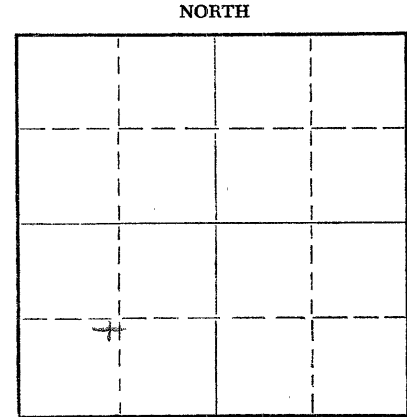

Locate well correctly on above
Section Plat

Name of Conservation Agent who supervised plugging of this well A. D. Fabricuis

Producing formation _____ Depth to top _____ Bottom _____ Total Depth of Well 4113 Feet

Show depth and thickness of all water, oil and gas formations.

OIL, GAS OR WATER RECORDS

CASING RECORD

FORMATION	CONTENT	FROM	TO	SIZE	PUT IN	PULLED OUT

Describe in detail the manner in which the well was plugged, indicating where the mud fluid was placed and the method or methods used in introducing it into the hole. If cement or other plugs were used, state the character of same and depth placed, from _____ feet to _____ feet for each plug set.

Filled back with sand to 4090' mixed and run 3 sacks cement
mud to 250' set 10' rock bridge mixed and dumped 25 sacks cement
mud to 40' set 10' rock bridge mixed and dumped 10 sacks cement.

RECEIVED
STATE CORPORATION COMMISSION
SEP 28 1959
CONSERVATION DIVISION
Wichita, Kansas

(If additional description is necessary, use BACK of this sheet)

Name of Plugging Contractor Southwest Casing Pulling Co., Inc.

Address Box 364, Great Bend, Kansas

STATE OF Kansas, COUNTY OF Barton, ss.

Southwest Casing Pulling Co., Inc. (employee of owner) or (owner or operator) of the above-described well, being first duly sworn on oath, says: That I have knowledge of the facts, statements, and matters herein contained and the log of the above-described well as filed and that the same are true and correct. So help me God.

(Signature) Roy L. Myers Sec. Treas.

Box 364, Great Bend, Kansas

(Address)

SUBSCRIBED AND SWORN TO before me this 25 day of September, 1959

My commission expires December 18, 1962

Juanita R. Myers

Notary Public.

PLUGGING

File Sec. 22 T 6 R 29W

Book Page 2 Line 37