


15-179-05228-00-00

WELL PLUGGING RECORD

Give All Information Completely  
Make Required Affidavit  
Mail or Deliver Report to:  
Conservation Division  
State Corporation Commission  
212 North Market, Insurance Bldg.  
Wichita, Kansas

Sheridan County, Sec. 22 Twp. 6 Rge. 29 (E) (W)

Location as "NE/CNW/SW" or footage from lines SW SW SW  
Lease Owner Drillers Producers Pipe & Supply Inc.  
Lease Name L.H. Wessell Well No. 1  
Office Address Box 368, Great Bend, Kansas  
Character of Well (completed as Oil, Gas or Dry Hole) oil  
Date well completed \_\_\_\_\_ 19\_\_\_\_  
Application for plugging filed September 10, 1959 19\_\_\_\_  
Application for plugging approved September 11, 1959 19\_\_\_\_  
Plugging commenced September 10, 1959 19\_\_\_\_  
Plugging completed September 15, 1959 19\_\_\_\_  
Reason for abandonment of well or producing formation dry

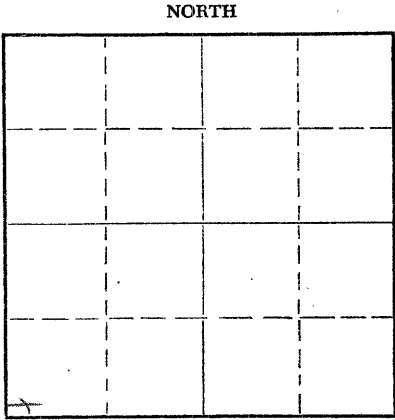

Locate well correctly on above Section Plat

If a producing well is abandoned, date of last production \_\_\_\_\_ 19\_\_\_\_  
Was permission obtained from the Conservation Division or its agents before plugging was commenced? yes

Name of Conservation Agent who supervised plugging of this well A. D. Fabricuis  
Producing formation \_\_\_\_\_ Depth to top \_\_\_\_\_ Bottom \_\_\_\_\_ Total Depth of Well 4125 Feet  
Show depth and thickness of all water, oil and gas formations.

OIL, GAS OR WATER RECORDS

CASING RECORD

FORMATION	CONTENT	FROM	TO	SIZE	PUT IN	PULLED OUT

Describe in detail the manner in which the well was plugged, indicating where the mud fluid was placed and the method or methods used in introducing it into the hole. If cement or other plugs were used, state the character of same and depth placed, from \_\_\_\_\_ feet to \_\_\_\_\_ feet for each plug set.

Filled back with sand to 4070' mixed and dumped 3 sacks cement  
mud hole to 500' set 10' rock bridge mixed and run 20 sacks cement  
mud to 230' set 10' rock bridge, mixed and run 20 sacks cement  
mud to 40' rock bridge with 10 sacks cement.

RECEIVED  
STATE CORPORATION COMMISSION

SEP 28 1959

CONSERVATION DIVISION  
Wichita, Kansas

9-28-59

(If additional description is necessary, use BACK of this sheet)  
Name of Plugging Contractor Southwest Casing Pulling Co., Inc.  
Address Box 364, Great Bend, Kansas

STATE OF Kansas, COUNTY OF Barton, ss.  
Southwest Casing Pulling Co., Inc. (employee of owner) or (owner or operator) of the above-described well, being first duly sworn on oath, says: That I have knowledge of the facts, statements, and matters herein contained and the log of the above-described well as filed and that the same are true and correct. So help me God.

(Signature) Roy L. Myers Roy L. Myers Sec. Treas.  
Box 364, Great Bend, Kansas  
(Address)

SUBSCRIBED AND SWORN TO before me this 25 day of September, 1959

My commission expires December 18, 1962  
Janita L. Myers Notary Public.

PLUGGING  
File Sec. 22 T 6 R 394  
Book Page 2 Line 34