

15-179-05239-00-00


STATE OF KANSAS
STATE CORPORATION COMMISSION

Give All Information Completely
Make Required Affidavit
Mail or Deliver Report to:
Conservation Division
State Corporation Commission
211 No. Broadway
Wichita, Kansas

WELL PLUGGING RECORD

Sherdin County, Sec 28 Twp. 6 Rge. 29 (E) (W)

Location as "NE/CNW/SW" or footage from lines NE NE NE
Lease Owner Morganstern & Spector
Lease Name Enigh Well No. 2
Office Address Russell, Kansas
Character of Well (completed as Oil, Gas or Dry Hole) oil
Date well completed 10-23-53 19__
Application for plugging filed June 30, 1958 19__
Application for plugging approved July 2, 1958 19__
Plugging commenced 7/9/58 19__
Plugging completed 7/25/58 19__
Reason for abandonment of well or producing formation failure to produce profitably
If a producing well is abandoned, date of last production May, 1958 19__
Was permission obtained from the Conservation Division or its agents before plugging was commenced? Yes

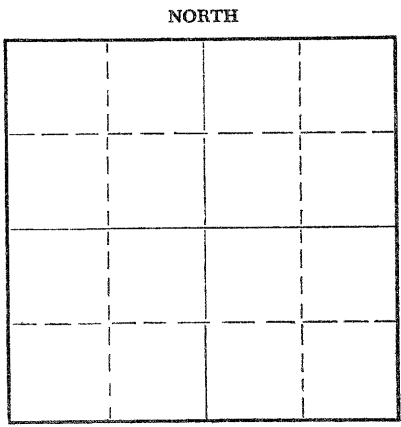

Locate well correctly on above Section Plat

Name of Conservation Agent who supervised plugging of this well Eldon Petty
Producing formation Kansas City Depth to top 3939 Bottom 4136 Total Depth of Well 4136 Feet
Show depth and thickness of all water, oil and gas formations.

OIL, GAS OR WATER RECORDS

CASING RECORD

| FORMATION | CONTENT | FROM | TO | SIZE | PUT IN | PULLED OUT |
|-----------|---------|------|----|-----------|--------|------------|
| | | | | 8 5/8" OD | 256 | none |
| | | | | 5 1/2" OD | 4135' | 1598 feet |
| | | | | | | |
| | | | | | | |
| | | | | | | |
| | | | | | | |
| | | | | | | |

Describe in detail the manner in which the well was plugged, indicating where the mud fluid was placed and the method or methods used in introducing it into the hole. If cement or other plugs were used, state the character of same and depth placed, from _____ feet to _____ feet for each plug set.

Plugged back with sand 4,070 ft. Dumped 4 sacks cement. Mudded hole up to 256 ft.
Set 10 foot rock bridge. Dumped 25 sacks cement. Mudded hole up to 40 ft.,
Set rock bridge. Dumped 10 sacks cement.

(If additional description is necessary, use BACK of this sheet)

Name of Plugging Contractor E & L Casing Pulling Co.
Address 1116 Coolidge, Great Bend, Kansas

STATE OF Kansas, COUNTY OF Russell, ss.
Morganstern & Spector (employee of owner) or (owner or operator) of the above-described well, being first duly sworn on oath, says: That I have knowledge of the facts, statements, and matters herein contained and the log of the above-described well as filed and that the same are true and correct. So help me God.

(Signature) [Signature]

(Address) _____

SUBSCRIBED AND SWORN TO before me this 30th day of July, 1958

My commission expires Dec. 1, 1959

Elsie Coady
Elsie Coady Notary Public.

RECEIVED
STATE CORPORATION COMMISSION
SEP 26 1958
CONSERVATION DIVISION
WICHITA, KANSAS
9-26-58

PLUGGING
FILE NO. 28 6 R29W
BOOK PAGE 112 LINE 2