


STATE OF KANSAS
STATE CORPORATION COMMISSION

15-179-05233-00-00
WELL PLUGGING RECORD

Give All Information Completely
Make Required Affidavit
Mail or Deliver Report to:
Conservation Division
State Corporation Commission
212 North Market, Insurance Bldg.
Wichita, Kansas

Sheridan County, Sec. 27 Twp. 6 Rge. 29 (E) (W)

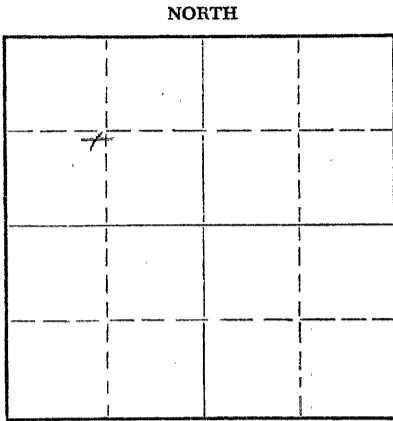

Locate well correctly on above Section Plat

Location as "NE/CNW $\frac{1}{2}$ SW $\frac{1}{2}$ " or footage from lines NE SW NW
Lease Owner Drillers-Producers Pipe & Supply Co.
Lease Name Box 368 E. Wessell Well No. 3
Office Address Great Bend, Kansas
Character of Well (completed as Oil, Gas or Dry Hole) dil
Date well completed _____ 19____
Application for plugging filed September 10, 1959 19____
Application for plugging approved September 11, 1959 19____
Plugging commenced September 9, 1959 19____
Plugging completed September 15, 1959 19____
Reason for abandonment of well or producing formation dry

If a producing well is abandoned, date of last production _____ 19____
Was permission obtained from the Conservation Division or its agents before plugging was commenced? yes

Name of Conservation Agent who supervised plugging of this well A. D. Fabricius
Producing formation _____ Depth to top _____ Bottom _____ Total Depth of Well 4143 Feet
Show depth and thickness of all water, oil and gas formations.

OIL, GAS OR WATER RECORDS

CASING RECORD

FORMATION	CONTENT	FROM	TO	SIZE	PUT IN	PULLED OUT

Describe in detail the manner in which the well was plugged, indicating where the mud fluid was placed and the method or methods used in introducing it into the hole. If cement or other plugs were used, state the character of same and depth placed, from _____ feet to _____ feet for each plug set.

Sanded back to 4020 mixed and run 3 sacks cement with bailer
Mud to 500' set 10' rock bridge run 20 sacks
mud to 250' set 10' rock bridge run 20 sacks cement
mud to 40' set 10' rock bridge with 10 sacks cement

RECEIVED
STATE CORPORATION COMMISSION
SEP 28 1959
CONSERVATION DIVISION
Wichita, Kansas

(If additional description is necessary, use BACK of this sheet)
Name of Plugging Contractor Southwest Casing Pulling Co., Inc.
Address Box 364, Great Bend, Kansas

STATE OF Kansas, COUNTY OF Barton, ss.
Southwest Casing Pulling Co., Inc. (employee of owner) or (owner or operator) of the above-described well, being first duly sworn on oath, says: That I have knowledge of the facts, statements, and matters herein contained and the log of the above-described well as filed and that the same are true and correct. So help me God.

(Signature) Roy L. Myers Roy L. Myers Sec. Treas.
Box 364, Great Bend, Kansas
(Address)

SUBSCRIBED AND SWORN TO before me this 25 day of September, 19 59

My commission expires December 18, 1962
Granita R. Myers Notary Public.

PLUGGING
File Sec. T R
Book Page _____ Line _____