

15-179-00040-00-00


STATE OF KANSAS
STATE CORPORATION COMMISSION

Give All Information Completely
Make Required Affidavit
Mail or Deliver Report to:
Conservation Division
State Corporation Commission
800 Bitting Building
Wichita, Kansas

WELL PLUGGING RECORD

Sheridan County. Sec. 25 Twp. 6 Rge. 29 (W)
Location as "NE/CNW $\frac{1}{4}$ SW $\frac{1}{4}$ " or footage from lines SW NW NE
Lease Owner Thos. H. Allan, Henderson Oil Co., et al.
Lease Name Godfrey Well No. 1
Office Address 1221 Union National Bank Bldg., Wichita 2, Kansas
Character of Well (completed as Oil, Gas or Dry Hole) Dry Hole
Date well completed May 27 19 53
Application for plugging filed May 27 19 53
Application for plugging approved May 27 19 53
Plugging commenced May 27 19 53
Plugging completed May 27 19 53
Reason for abandonment of well or producing formation Dry Hole

NORTH

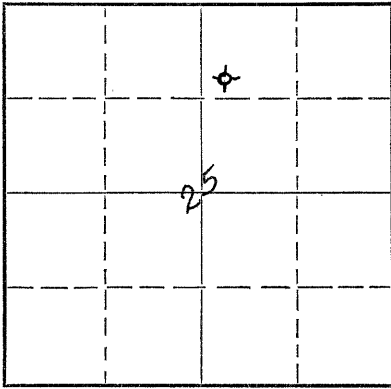

Locate well correctly on above
Section Plat

If a producing well is abandoned, date of last production --- 19 ---
Was permission obtained from the Conservation Division or its agents before plugging was commenced? Yes

Name of Conservation Agent who supervised plugging of this well Eldon Petty
Producing formation Lansing K.C. Depth to top 3879 Bottom 4097 Total Depth of Well 4100 Feet
Show depth and thickness of all water, oil and gas formations.

OIL, GAS OR WATER RECORDS

CASING RECORD

Formation	Content	From	To	Size	Put In	Pulled Out
				8 5/8"	255'	None

Describe in detail the manner in which the well was plugged, indicating where the mud fluid was placed and the method or methods used in introducing it into the hole. If cement or other plugs were used, state the character of same and depth placed, from --- feet to --- feet for each plug set.

4100 - 240 Heavy Rotary mud
240 - 160 Wood and rock bridge and 25 sacks cement
160 - 40 Rotary mud
40 - Surface Wood and rock bridge, hulls, and 10 sacks cement

6-4-53

(If additional description is necessary, use BACK of this sheet)

Name of Plugging Contractor THOS. H. ALLAN
Address 1221 Union National Bank Building, Wichita 2, Kansas

STATE OF KANSAS, COUNTY OF SEDGWICK, ss.
Thos. H. Allan (employee of owner) or (owner or operator) of the above-described well,
being first duly sworn on oath, says: That I have knowledge of the facts, statements, and matters herein contained and the log of the above-described well as filed and that the same are true and correct. So help me God.

(Signature) Thos. H. Allan

1221 Union Nat'l. Bank Bldg., Wichita 2, Kans.
(Address)

SUBSCRIBED AND SWORN to before me this 3 day of June, 19 53

Ocie M. Stewart
Notary Public.

My commission expires June 14, 1954

