


15-189-052540000

WELL PLUGGING RECORD

Give All Information Completely
Make Required Affidavit
Mail or Deliver Report to:
Conservation Division
State Corporation Commission
800 Bitting Building
Wichita, Kansas

NORTH

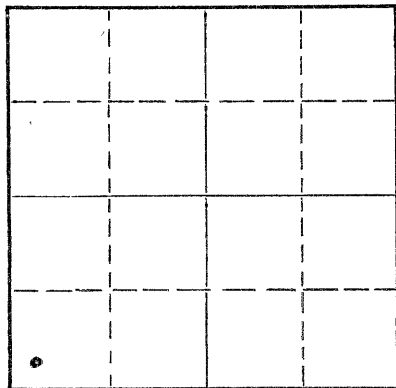

Locate well correctly on above
Section Plat

Sheridan County. Sec. 15 Twp. 6 Rge. 29 (E) W (W)
Location as "NE/CNW/SW" or footage from lines SW-SW-SW
Lease Owner Western Hydrocarbon Company
Lease Name NEFF "B" Well No. 1
Office Address 700 Jones Bldg - Corpus Christi, Texas
Character of Well (completed as Oil, Gas or Dry Hole) Oil
Date well completed March 21 1954
Application for plugging filed July 9 1957
Application for plugging approved July 11 1957
Plugging commenced Aug 3 1957
Plugging completed Aug 12 1957
Reason for abandonment of well or producing formation No Fluid

If a producing well is abandoned, date of last production May 31 1957
Was permission obtained from the Conservation Division or its agents before plugging was commenced? Yes

Name of Conservation Agent who supervised plugging of this well Eldon Perry
Producing formation KANSAS City Depth to top 3930 Bottom _____ Total Depth of Well 4120 Feet
Show depth and thickness of all water, oil and gas formations.

OIL, GAS OR WATER RECORDS

CASING RECORD

FORMATION	CONTENT	FROM	TO	SIZE	PUT IN	PULLED OUT
			259'	8 1/8 5 1/2	259 4120	NONE 2615

Describe in detail the manner in which the well was plugged, indicating where the mud fluid was placed and the method or methods used in introducing it into the hole. If cement or other plugs were used, state the character of same and depth placed, from _____ feet to _____ feet for each plug set.

Plug Back with Sand from 4092 to 4060
& Dumped 4 Sack Cement
Mudded Hole to 259', set 10' Rock Bridge,
Mixed & Dumped 20 Sack Cement, Mudded
Hole to 35' set 10' Rock Bridge, Mixed
& Poured 10 Sack Cement to Base of Casing

Name of Plugging Contractor Ace Pipe Pulling Co
Address Great Bend, Kansas

STATE OF KANSAS COUNTY OF PAWNEE ss. J. L. Haines (employee of owner) or (owner or operator) of the above-described well, being first duly sworn on oath, says: That I have knowledge of the facts, statements, and matters herein contained and the log of the above-described well as filed and that the same are true and correct. So help me God.

(Signature) J. L. Haines
(Address) Larned Kansas

SUBSCRIBED AND SWORN TO before me this 10 day of Sept, 1957
J. Wayne Poor Notary Public.

My commission expires 7-11-61

PLUGGING
FILE SEC 15 T. 6 R. 29W
BOOK PAGE 26 LINE 29

15-179-05254-0000

DRILLER'S LOG

Company - Westpan Hydrocarbon Company
Contractor - Bill Hay Drilling Company
Well No. - Neff No. B-1
Commenced - November 22, 1953
Completed - December 2, 1953

Location - SW SW SW Sec. 15-6S-
29W, Sheridan County, Kansas
Elevation - 2796' (KB)
Casing - 8 ⁷/₈" @ 259' w/160
sacks.
5 1/2" @ 4120' w/160
sacks.

<u>FORMATION</u>	<u>DEPTH</u>
Surface Sand & Shale	200
Sandy Shale	240
Yellow Clay	250
Blue Shale	259
Shale & Shells	400
Sandy Shale	560
Shale & Shells	1390
Shale, Shells & Sand	1540
Shale & Shells	1820
Shale & Pyrite Streaks	1850
Shale & Streaks of Sand	2115
Shale & Shells	2515
Lime-Shale-Anhydrite	2730
Shale & Shells	3070
Shale & Streaks of Lime	3305
Lime & Shale	4020
Lime	4120 TD

RECEIVED
STATE CORPORATION COMMISSION

SEP 12 1953

9-12-53

CONSERVATION DIVISION

PLUGGING	
FILE	SEC 15 T 6 R 29W
BOOK	PAGE 26 LINE 29