


STATE OF KANSAS
STATE CORPORATION COMMISSION

75-179-00050-00-00

Give All Information Completely
Make Required Affidavit
Mail or Deliver Report to:
Conservation Division
State Corporation Commission
800 Bitting Building
Wichita, Kansas

WELL PLUGGING RECORD

NORTH

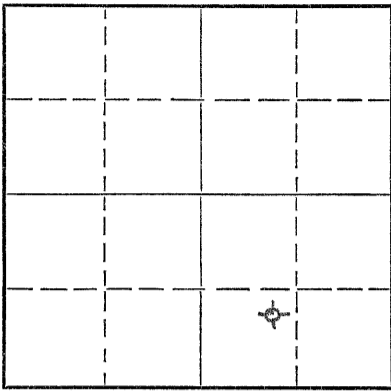

Locate well correctly on above
Section Plat

Sheridan County. Sec. 21 Twp. 6 Rge. 29 ~~W~~ (W)
Location as "NE/CNW¹/₄SW¹/₄" or footage from lines NE SW SE
Lease Owner THE HENDERSON OIL CO., et al
Lease Name NEFF Well No. 2
Office Address 502 Orpheum Building, Wichita, Kansas
Character of Well (completed as Oil, Gas or Dry Hole) Dry Hole
Date well completed August 20th 19 54
Application for plugging filed August 20th 19 54
Application for plugging approved August 20th 19 54
Plugging commenced August 20th 19 54
Plugging completed August 20th 19 54
Reason for abandonment of well or producing formation Dry

If a producing well is abandoned, date of last production none 19
Was permission obtained from the Conservation Division or its agents before plugging was commenced? yes

Name of Conservation Agent who supervised plugging of this well Warren Horner
Producing formation Lansing K.G. Depth to top 3970 Bottom 4185 Total Depth of Well 4192 Feet
Show depth and thickness of all water, oil and gas formations.

OIL, GAS OR WATER RECORDS

CASING RECORD

Formation	Content	From	To	Size	Put In	Pulled Out
				8 5/8"	262	0

Describe in detail the manner in which the well was plugged, indicating where the mud fluid was placed and the method or methods used in introducing it into the hole. If cement or other plugs were used, state the character of same and depth placed, from _____ feet to _____ feet for each plug set.

Hole filled with heavy mud to 255'
Ran plug and one-half sack hulls to 255'
Cemented with 15 sacks
Filled hole with heavy mud to 40'
Ran plug and one-half sack hulls to 40'
Cemented with 10 sacks
Filled to surface with soil.

State of Kansas
Conservation Division
Wichita, Kansas
8-24-54


(If additional description is necessary, use BACK of this sheet)
Name of Plugging Contractor BILL HAY DRILLING CO.
Address HOUSTON, KANSAS

STATE OF KANSAS, COUNTY OF Sedgwick, ss.
J. A. HENDERSON (employee of owner) ~~is~~ of the above-described well,
being first duly sworn on oath, says: That I have knowledge of the facts, statements, and matters herein contained and the log of the above-described well as filed and that the same are true and correct. So help me God.

(Signature) J. A. Henderson
502 Orpheum Bldg., Wichita, Kansas
(Address)

SUBSCRIBED AND SWORN to before me this 23rd day of August, 1954.
Notary Public.

My commission expires April 28, 1958

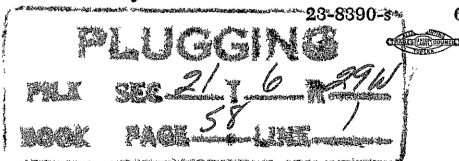

23-8390-3 6-51-20M