

15-179-05586-00-00


STATE OF KANSAS
STATE CORPORATION COMMISSION

Give All Information Completely
Make Required Affidavit
Mail or Deliver Report to:
Conservation Division
State Corporation Commission
800 Bittling Building
Wichita, Kansas

WELL PLUGGING RECORD

Sheridan County, Sec. 16 Twp. 6 Rge. 29 (E) (W)

NORTH

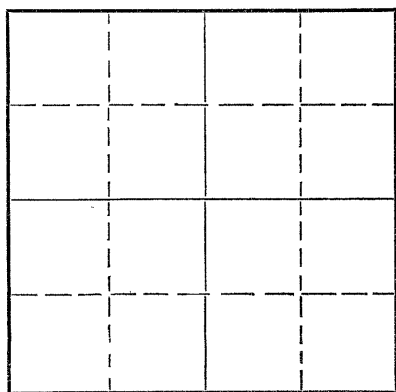

Locate well correctly on above
Section Plat

Location as "NE/CNW/SW" or footage from lines _____
Lease Owner W. W. Sauvage
Lease Name Brantley Well No. 3
Office Address Oberlin, Kansas
Character of Well (completed as Oil, Gas or Dry Hole) dry
Date well completed 5-7 19 56
Application for plugging filed 5-8 19 56
Application for plugging approved 5-8 19 56
Plugging commenced 5-8 19 56
Plugging completed 5-8 19 56
Reason for abandonment of well or producing formation unproducing

If a producing well is abandoned, date of last production _____ 19 _____
Was permission obtained from the Conservation Division or its agents before plugging was commenced? yes

Name of Conservation Agent who supervised plugging of this well Eldon Petty
Producing formation _____ Depth to top _____ Bottom _____ Total Depth of Well 4210 Feet
Show depth and thickness of all water, oil and gas formations.

OIL, GAS OR WATER RECORDS

CASING RECORD

| FORMATION | CONTENT | FROM | TO | SIZE | PUT IN | PULLED OUT |
|-----------|---------|------|----|------|--------|------------|
| | | | | | | |
| | | | | | | |
Describe in detail the manner in which the well was plugged, indicating where the mud fluid was placed and the method or methods used in introducing it into the hole. If cement or other plugs were used, state the character of same and depth placed, from _____ feet to _____ feet for each plug set.

Plugged back with sand to 4070 ft. Ran 4 sx cement with dump bailer. Mudded hole with heavy mud to bottom of surface. Set plug 180 ft., 15 sx cement 1/2 sx hulls. Filled hole with heavy mud. Set plug at 35 ft., 10 sx cement and 1/2 sx hulls.

(If additional description is necessary, use BACK of this sheet.)

Name of Plugging Contractor Sauvage & Sons Well Co. Inc
Address _____

STATE OF Kansas, COUNTY OF Deeatur, ss.

(employee of owner) or (owner or operator) of the above-described well, being first duly sworn on oath, says: That I have knowledge of the facts, statements, and matters herein contained and the log of the above-described well as filed and that the same are true and correct. So help me God.

(Signature) W. W. Sauvage

Oberlin, Kansas
(Address)

SUBSCRIBED AND SWORN TO before me this 10th day of May, 19 56

My commission expires May 17, 1959

24-7368-5 3-53-20M

Notary Public.

PLUGGING
FILE SEC. 16 T. 6 R. 29 W
BOOK PAGE 60 LINE 13

5-14-56