

CARD MUST BE TYPED

State of Kansas
NOTICE OF INTENTION TO DRILL

Corrected
CARD MUST BE SIGNED
12-4-84

~~5 days after approval~~

(see rules on reverse side)

Starting Date: 12 9 84
month day year

API Number 15- 121-26,254-00-00

OPERATOR: License # 5985

SE 1/4 Sec 23. Twp 16S, Rge 21. East
(location) West

Name ..Gerald E. Williams

Address ...P.O. Box 25830

City/State/Zip ..O.P., KS 66225

Contact Person ...Gerald E. Williams

Phone ...913-451-6022

* 165 1125 Ft North from Southeast Corner of Section
* 1550 1800 Ft West from Southeast Corner of Section.
(Note: Locate well on Section Plat on reverse side)

CONTRACTOR: License # 5353

Nearest lease or unit boundary line 165 feet.

Name ..Bloomer Well Service

County Miami

City/State ..Rantoul, KS 66079

Lease Name Booze Well# 8

Domestic well within 330 feet: yes No

Municipal well within one mile: yes No

Well Drilled For: Well Class: Type Equipment:

- Oil Swd Infield Mud Rotary
- Gas Inj Pool Ext. Air Rotary
- OWWO Expl Wildcat Cable

Depth to Bottom of fresh water 20 feet

Lowest usable water formation

Depth to Bottom of usable water 200 feet

Surface pipe by Alternate: 1 2

Surface pipe to be set 21 feet

Conductor pipe if any required none feet

Ground surface elevation n/a feet MSL

This Authorization Expires 1-19-85

Approved By 7-19-84

If OWWO: old well info as follows:

Operator

Well Name

Comp Date Old Total Depth

Projected Total Depth 750 feet

Projected Formation at TD 700

Expected Producing Formations squirrel

I certify that we will comply with K.S.A. 55-101, et seq., plus eventually plugging hole to K.C.C. specifications. *KWS, 1125 FSL*

Date 11/19/84... Signature of Operator or Agent


Title Operator

1800 FEL

**Must be filed with the K.C.C. five (5) days prior to commencing well
This card void if drilling not started within six (6) months of date received by K.C.C.**

Important procedures to follow :

**A Regular Section of Land
1 Mile = 5,280 Ft.**

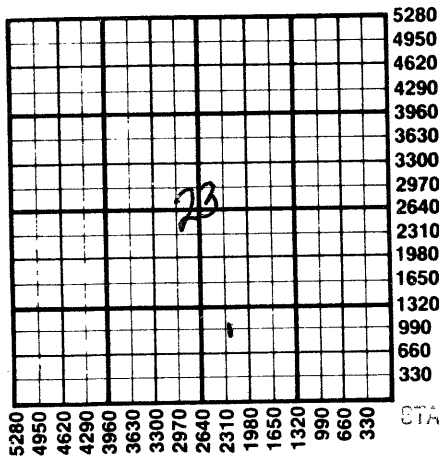

1. Notify District office before setting surface casing.
2. Set surface casing by circulating cement to the top.
3. File completion forms ACO-1 with K.C.C. within 90 days of well completion, following instructions on ACO-1, side 1, and including copies of wireline logs.
4. Notify District office 48 hours prior to old well workover or re-entry.
5. Prior to plugging, prepare a plugging plan, then obtain agreement from the appropriate district office for an approved plugging plan.
6. Submit plugging report (CP-4) to K.C.C. after plugging is completed.
7. Obtain an approved injection docket number before disposing of salt water.
8. Notify K.C.C. within 10 days when injection commences or terminates.
9. If an alternate 2 completion, cement in the production pipe from below any usable water to surface within 120 days of spud date.

RECEIVED
STATE CORPORATION COMMISSION

**State Corporation Commission of Kansas
Conservation Division
200 Colorado Derby Building
Wichita, Kansas 67202
(316) 263-3238**

DEC 03 1984

CONSERVATION DIVISION
Wichita, Kansas