

CARD MUST BE TYPED

State of Kansas
NOTICE OF INTENTION TO DRILL
(see rules on reverse side)

CARD MUST BE SIGNED

Starting Date: Aug. 12, 85
month day year

API Number 15- 121-26,624-00-00

OPERATOR: License # 5876
Name Diamond B Inds., Inc.
Address R.R. 1
City/State/Zip Paola, KS 66071
Contact Person Jim Ferley
Phone 913-294-3841

. NW. SE. NE Sec .23 Twp .16. S, Rge .21. East
(location) West

3566... Ft North from Southeast Corner of Section
2650... Ft West from Southeast Corner of Section
(Note: Locate well on Section Plat on reverse side)

CONTRACTOR: License #
Name company tools
City/State

Nearest lease or unit boundary line 10 feet.
County Miami
Lease Name Henning Well# EH-9

Domestic well within 330 feet: yes no
Municipal well within one mile: yes no

Well Drilled For: Well Class: Type Equipment:
 Oil Swd Infield Mud Rotary
 Gas Inj Pool Ext. Air Rotary
 OWWO Expl Wildcat Cable

Depth to Bottom of fresh water 15 feet
Lowest usable water formation
Depth to Bottom of usable water 200 feet
Surface pipe by Alternate: 1 2
Surface pipe to be set 20 feet
Conductor pipe if any required na feet
Ground surface elevation 997 feet MSL

If OWWO: old well info as follows:

Operator
Well Name
Comp Date Old Total Depth
Projected Total Depth 700 feet
Projected Formation at TD squirrel
Expected Producing Formations squirrel

This Authorization Expires 2-9-86
Approved By 8-9-85 *[Signature]* **Rec'd for K.D.H.E.**

I certify that we will comply with K.S.A. 55-101, et seq., plus eventually plugging hole to K.C.C. specifications.


Date Aug 6, 85 Signature of Operator or Agent *Jim Ferley* Title Vice-President

CONSERVATION DIVISION
WICHITA, KANSAS

RECEIVED
STATE CORPORATION COMMISSION
58-9-80
AUG 9 1985

Must be filed with the K.C.C. five (5) days prior to commencing well
This card void if drilling not started within six (6) months of date received by K.C.C.

Regular Section of Land
1 Mile = 5,280 Ft.

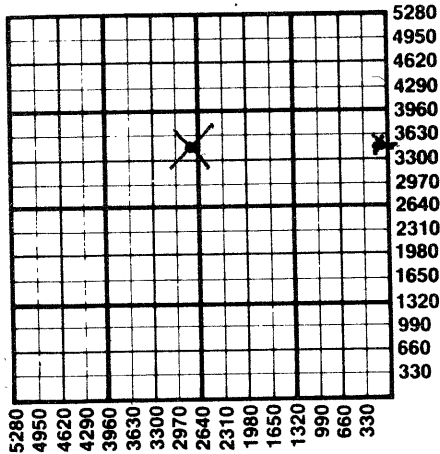

Important procedures to follow:

1. Notify District office before setting surface casing.
2. Set surface casing by circulating cement to the top.
3. File completion forms ACO-1 with K.C.C. within 90 days of well completion, following instructions on ACO-1, side 1, and including copies of wireline logs.
4. Notify District office 48 hours prior to old well workover or re-entry.
5. Prior to plugging, prepare a plugging plan, then obtain agreement from the appropriate district office for an approved plugging plan.
6. Submit plugging report (CP-4) to K.C.C. after plugging is completed.
7. Obtain an approved injection docket number before disposing of salt water.
8. Notify K.C.C. within 10 days when injection commences or terminates.
9. If an alternate 2 completion, cement in the production pipe from below any usable water to surface within 120 days of spud date.

State Corporation Commission of Kansas
Conservation Division
200 Colorado Derby Building
Wichita, Kansas 67202
(316)263-3238