

CARD MUST BE TYPED


State of Kansas
NOTICE OF INTENTION TO DRILL
(see rules on reverse side)

CARD MUST BE SIGNED

Starting Date: ...May..6, 1985.....
month day year

API Number 15- 121-26,532-00-00

OPERATOR: License #5876.....
NameDiamond B. Inds., Inc.....
AddressR. R. 1.....
City/State/ZipPaola, KS.....66071.....
Contact PersonJim Ferley.....
Phone913-294-3841.....

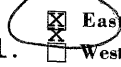. NW *NE NW* Sec 2.3 . Twp .16. S, Rge 21. 

..4988..... Ft North from Southeast Corner of Section
..3624..... Ft West from Southeast Corner of Section
(Note: Locate well on Section Plat on reverse side)

CONTRACTOR: License #
Namecompany tools.....
City/State

Nearest lease or unit boundary line292..... feet.
CountyMiami.....
Lease Name Henning..... Well# EH.2.....
Domestic well within 330 feet : yes no
Municipal well within one mile : yes no

Well Drilled For: Well Class: Type Equipment:
 Oil Swd Infield Mud Rotary
 Gas Inj Pool Ext. Air Rotary
 OWWO Expl Wildcat Cable

Depth to Bottom of fresh water15..... feet
Lowest usable water formation
Depth to Bottom of usable water200..... feet
Surface pipe by Alternate : 1 2
Surface pipe to be set ..20..... feet
Conductor pipe if any requiredna..... feet
Ground surface elevation990..... feet MSL
This Authorization Expires10-29-85.....
Approved By4-29-85 *R*.....

If OWWO: old well info as follows:
Operator
Well Name
Comp Date Old Total Depth
Projected Total Depth700..... feet
Projected Formation at TD...Squirrel.....
Expected Producing FormationsSquirrel.....

I certify that we will comply with K.S.A. 55-101, et seq., plus eventually plugging hole to K.C.C. specifications.

Date 4-24-85 Signature of Operator or Agent

Jim Ferley


Title Vice-President

with KDOHE 4-29-85

Must be filed with the K.C.C. five (5) days prior to commencing well
This card void if drilling not started within six (6) months of date received by K.C.C.

Important procedures to follow :

A Regular Section of Land
1 Mile = 5,280 Ft.

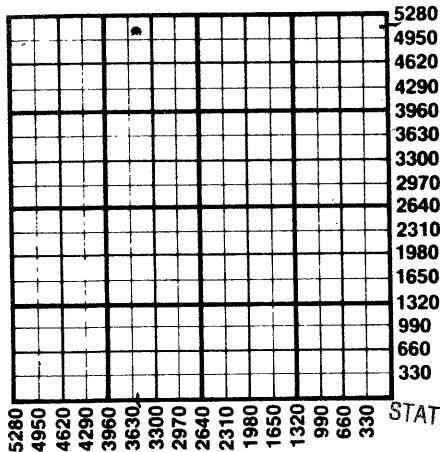

1. Notify District office before setting surface casing.
2. Set surface casing by circulating cement to the top.
3. File completion forms ACO-1 with K.C.C. within 90 days of well completion, following instructions on ACO-1, side 1, and including copies of wireline logs.
4. Notify District office 48 hours prior to old well workover or re-entry.
5. Prior to plugging, prepare a plugging plan, then obtain agreement from the appropriate district office for an approved plugging plan.
6. Submit plugging report (CP-4) to K.C.C. after plugging is completed.
7. Obtain an approved injection docket number before disposing of salt water.
8. Notify K.C.C. within 10 days when injection commences or terminates.
9. If an alternate 2 completion, cement in the production pipe from below any usable water to surface within 120 days of spud date.

RECEIVED

STATE CORPORATION COMMISSION

APR 29 1985

CONSERVATION DIVISION
Wichita, Kansas

State Corporation Commission of Kansas
Conservation Division
200 Colorado Derby Building
Wichita, Kansas 67202
(316) 263-3238