

CARD MUST BE TYPED

State of Kansas  
NOTICE OF INTENTION TO DRILL  
(see rules on reverse side)

CARD MUST BE SIGNED

Starting Date: November 11, 1985  
month day year

API Number 15-

121-26,702-00-00  
East

OPERATOR: License # 6540

*Not So New*

NE Sec 23.. Twp 16.. S, Rge 21..

Name Jack W. Sanders

Address R.R. 2 Box 189C

City/State/Zip Wellsville, Kansas 66092

Contact Person Jack W. Sanders

Phone 883-2384

4402 Ft North from Southeast Corner of Section  
2183 Ft West from Southeast Corner of Section  
(Note: Locate well on Section Plat on reverse side)

CONTRACTOR: License # 5820

Name Kent Drilling Co.

City/State Garnett, Kansas

Nearest lease or unit boundary line 430 feet.

County Miami

Lease Name Huffman Well# Inj.. 1..

Domestic well within 330 feet:  yes  no

Municipal well within one mile:  yes  no

Well Drilled For: Well Class: Type Equipment:

- Oil  Swd  Infield  Mud Rotary
- Gas  Inj  Pool Ext.  Air Rotary
- OWWO  Expl  Wildcat  Cable

Depth to Bottom of fresh water ~~200~~ EST 20' feet

Lowest usable water formation ~~None~~

Depth to Bottom of usable water 200 feet

Surface pipe by Alternate: 1  2

Surface pipe to be set 20 feet

Conductor pipe if any required feet

Ground surface elevation feet MSL

This Authorization Expires 5-6-86

Approved By 11-6-85

If OWWO: old well info as follows:

Operator

Well Name

Comp Date Old Total Depth

Projected Total Depth 700' feet

Projected Formation at TD

Expected Producing Formations


I certify that we will comply with K.S.A. 55-101, et seq., plus eventually plugging hole to K.C.C. specifications.

Date 11/4/85 Signature of Operator or Agent Jack W. Sanders Title Owner

**Must be filed with the K.C.C. five (5) days prior to commencing well  
This card void if drilling not started within six (6) months of date received by K.C.C.**

**Important procedures to follow :**

**A Regular Section of Land  
1 Mile = 5,280 Ft.**

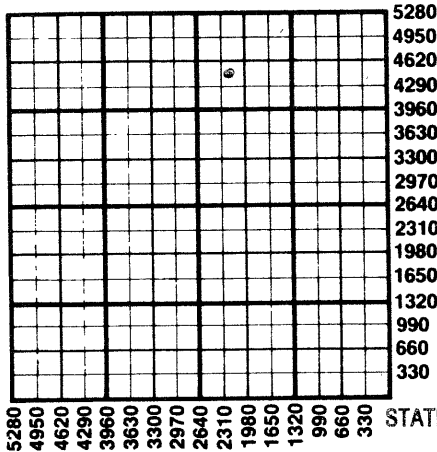

1. Notify District office before setting surface casing.
2. Set surface casing by circulating cement to the top.
3. File completion forms ACO-1 with K.C.C. within 90 days of well completion, following instructions on ACO-1, side 1, and including copies of wireline logs.
4. Notify District office 48 hours prior to old well workover or re-entry.
5. Prior to plugging, prepare a plugging plan, then obtain agreement from the appropriate district office for an approved plugging plan.
6. Submit plugging report (CP-4) to K.C.C. after plugging is completed.
7. Obtain an approved injection docket number before disposing of salt water.
8. Notify K.C.C. within 10 days when injection commences or terminates.
9. If an alternate 2 completion, cement in the production pipe from below and use water to surface within 120 days of spud date.

RECEIVED

STATE CORPORATION COMMISSION

11-06-85  
NOV 6 1985

State Corporation Commission of Kansas

Conservation Division  
200 Colorado Derby Building  
Wichita, Kansas 67202  
(316) 263-3238

CONSERVATION DIVISION  
Wichita, Kansas