

CARD MUST BE TYPED

State of Kansas  
NOTICE OF INTENTION TO DRILL  
(see rules on reverse side)

CARD MUST BE SIGNED

Starting Date: November 14, 1985  
month day year

API Number 15- 121-26,703-00 - Inj ✓  
New NE Sec. 23. Twp 16... S, Rge 21.  East  West

OPERATOR: License # 6540  
Name Jack W. Sanders  
Address R.R. # 2 Box 189-C  
City/State/Zip Wellsville, Kansas 66092  
Contact Person Jack W. Sanders  
Phone 913-883-2384

(location) 4823 Ft North from Southeast Corner of Section  
2183 Ft West from Southeast Corner of Section  
(Note: Locate well on Section Plat on reverse side)

CONTRACTOR: License # 5820  
Name Kent Drilling Co.  
City/State Garnett, Kansas

Nearest lease or unit boundary line 430 feet.  
County Miami  
Lease Name Huffman Well# Inj. 2

Domestic well within 330 feet:  yes  no  
Municipal well within one mile:  yes  no

Well Drilled For: Well Class: Type Equipment:  
 Oil  Swd  Infield  Mud Rotary  
 Gas  Inj  Pool Ext.  Air Rotary  
 OWWO  Expl  Wildcat  Cable

Depth to Bottom of fresh water ~~200~~ feet  
Lowest usable water formation ~~200~~  
Depth to Bottom of usable water 200 feet  
Surface pipe by Alternate: 1  2   
Surface pipe to be set 20 feet  
Conductor pipe if any required  
Ground surface elevation feet MSL  
This Authorization Expires 5-6-86  
Approved By 11-6-85 [Signature]

If OWWO: old well info as follows:  
Operator  
Well Name  
Comp Date Old Total Depth  
Projected Total Depth 200 feet  
Projected Formation at TD  
Expected Producing Formations


I certify that we will comply with K.S.A. 55-101, et seq., plus eventually plugging hole to K.C.C. specifications.

Date 11/4/85 Signature of Operator or Agent Jack W. Sanders Title Owner [Signature]  
Form C-1 4/84

**Must be filed with the K.C.C. five (5) days prior to commencing well  
This card void if drilling not started within six (6) months of date received by K.C.C.**

**Important procedures to follow :**

**A Regular Section of Land  
1 Mile = 5,280 Ft.**

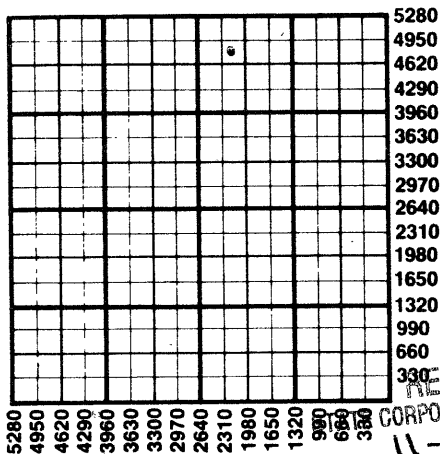

1. Notify District office before setting surface casing.
2. Set surface casing by circulating cement to the top.
3. File completion forms ACO-1 with K.C.C. within 90 days of well completion, following instructions on ACO-1, side 1, and including copies of wireline logs.
4. Notify District office 48 hours prior to old well workover or re-entry.
5. Prior to plugging, prepare a plugging plan, then obtain agreement from the appropriate district office for an approved plugging plan.
6. Submit plugging report (CP-4) to K.C.C. after plugging is completed.
7. Obtain an approved injection docket number before disposing of salt water.
8. Notify K.C.C. within 10 days when injection commences or terminates.
9. If an alternate 2 completion, cement in the production pipe from below any reasonable water to surface within 120 days of spud date.

RECEIVED  
CORPORATION COMMISSION  
11-06-85  
NOV 6 1985  
CONSERVATION DIVISION  
Wichita, Kansas

**State Corporation Commission of Kansas  
Conservation Division  
200 Colorado Derby Building  
Wichita, Kansas 67202  
(316) 263-3238**