

CARD MUST BE TYPED

State of Kansas

CARD MUST BE SIGNED

### NOTICE OF INTENTION TO DRILL

(see rules on reverse side)

Expected Spud Date..... 6 4 1988  
month day year

API Number 15-121-26,910-00-00

OPERATOR: License # ..... 5095  
Name ..... GERALD E. WILLIAMS  
Address ..... P.O. BOX 25830  
City/State/Zip ..... Overland Park, Kans. 66225  
Contact Person..... Gerald E. Williams  
Phone..... (913) 451-6022

SW. SW. SE. Sec...23. Twp....16 S, Rg....21. \_\_\_ East  
620. .... Ft. from South Line of Section  
2200. .... Ft. from East Line of Section

(Note: Locate well on Section Plat on reverse side)

CONTRACTOR: License # ..... 5885  
Name ..... Alva G. Glaze Drlg. Co.  
City/State..... Olathe, Kansas 66061

Nearest lease or unit boundary line ..... 620 feet  
County ..... MIAMI

Well Drilled For: Well Class: Type Equipment:  
\_\_\_ Oil \_\_\_ Storage X Infield \_\_\_ Mud Rotary  
\_\_\_ Gas X Inj \_\_\_ Pool Ext. X Air Rotary  
\_\_\_ OWWO \_\_\_ Expl \_\_\_ Wildcat \_\_\_ Cable

Lease Name..... BOOZE Well # I-1

Ground surface elevation ..... feet MSL

Domestic well within 330 feet: \_\_\_yes Xno

Municipal well within one mile: \_\_\_yes Xno

Depth to bottom of fresh water..... 30

Depth to bottom of usable water ..... 200

Surface pipe by Alternate: 1 \_\_\_ 2 X

Surface pipe planned to be set ..... 20

Conductor pipe required ..... None

Projected Total Depth ..... 700 feet

Formation..... Squirrel

If OWWO: old well info as follows:  
Operator .....  
Well Name .....  
Comp Date..... Old Total Depth.....

I certify that well will comply with K.S.A. 55-101, et seq., plus eventually plugging hole to KCC specifications.

Date ..... 5-31-88 Signature of Operator or Agent ..... Title..... Agent.....

For KCC Use:  
Conductor Pipe Required ..... feet; Minimum Surface Pipe Required ..... 20 feet per Alt. X 2

This Authorization Expires 11-30-88 Approved By RCH 5-31-88


EFFECTIVE DATE: 6-5-88

Must be filed with the K.C.C. five (5) days prior to commencing well  
 This card void if drilling not started within six (6) months of date received by K.C.C.

**Important procedures to follow:**

1. Notify District office before setting surface casing.
2. Set surface casing by circulating cement to the top.
3. File completion forms ACO-1 with K.C.C. within 120 days of well spud date, following instructions on ACO-1, side 1, and including copies of wireline logs.
4. Notify District office 48 hours prior to old well workover or re-entry.
5. Prior to filing Intent, prepare a proposed plugging plan in case well is D & A, then obtain approval of plan when calling district office prior to setting surface pipe.
6. Submit plugging report (CP-4) to K.C.C. after plugging is completed.
7. Obtain an approved injection docket number before disposing of salt water.
8. Notify K.C.C. within 10 days when injection commences or terminates.

**A Regular Section of Land**  
 1 Mile = 5,280 Ft.

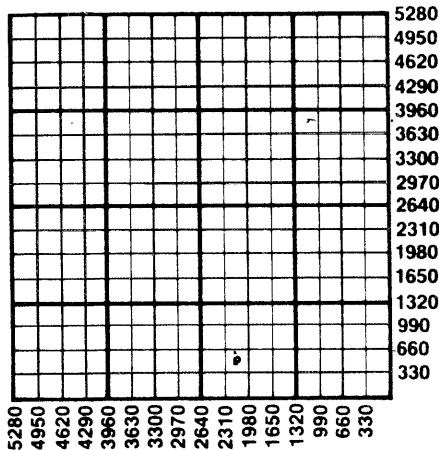

RECEIVED  
 STATE CORPORATION COMMISSION  

MAY 31 1988  
 CONSERVATION DIVISION  
 Wichita, Kansas

alternate 2 completion, cement in the production pipe from  
 below any usable water to surface within 120 days of spud date.

State Corporation Commission of Kansas  
 Conservation Division  
 200 Colorado Derby Building  
 Wichita, Kansas 67202-1212  
 (316) 263-3238