

15-193-00019-00-01

STATE OF KANSAS
STATE CORPORATION COMMISSION

Form CP-4

WELL PLUGGING RECORD

Give All Information Completely
Make Required Affidavit
Mail or Deliver Report to:
Conservation Division
State Corporation Commission
212 No. Market
Wichita, Kansas

Thomas

County. Sec. 8 Twp. 6S Rge. 31 (E) (W)

Location as "NE/CNW%SW%" or footage from lines NW NW SE

Lease Owner Rains & Williamson Oil Co., Inc.

Lease Name BARNETT "A" (OWWO) Well No. 1

Office Address 1425 Wichita Plaza - Wichita, Kansas

Character of Well (completed as Oil, Gas or Dry Hole) Dry Hole

Date well completed 9-7 1968

Application for plugging filed 9-7 1968

Application for plugging approved 9-7 1968


Plugging commenced 9-7 1968

Plugging completed 9-7 1968

Reason for abandonment of well or producing formation No oil or gas found in commercial quantities.

If a producing well is abandoned, date of last production 19

Was permission obtained from the Conservation Division or its agents before plugging was commenced? Yes

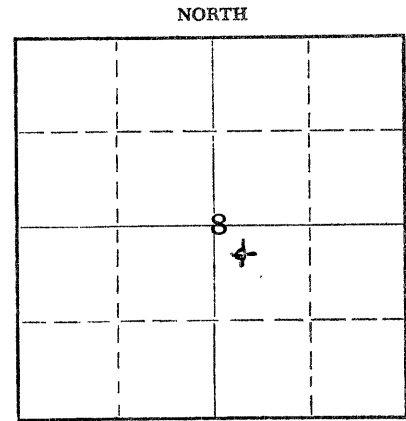

Locate well correctly on above Section Plat

Name of Conservation Agent who supervised plugging of this well Bill Nichols, Morland, Kansas

Producing formation Depth to top Bottom Total Depth of Well 4720 Feet

Show depth and thickness of all water, oil and gas formations.

OIL, GAS OR WATER RECORDS

CASING RECORD

FORMATION	CONTENT	FROM	TO	SIZE	Existing	PULLED OUT
				8-5/8"	321'	-0-

Describe in detail the manner in which the well was plugged, indicating where the mud fluid was placed and the method or methods used in introducing it into the hole. If cement or other plugs were used, state the character of same and depth placed, from feet to feet for each plug set.

Set first plug at 1800' with 100 sacks 50-50 pozmix, 6% gel.
Set second plug at 335' with 20 sacks same. Set solid bridge at 40' with 10 sacks cement, 2 sacks in rat hole. Plugging completed at 1:45 PM 9-7-68.

RECEIVED
STATE CORPORATION COMMISSION
SEP 26 1968
CONSERVATION DIVISION
Wichita, Kansas

9-26-68

(If additional description is necessary, use BACK of this sheet)
Name of Plugging Contractor Rains & Williamson Oil Co., Inc.
Address 1425 Wichita Plaza - Wichita, Kansas

STATE OF KANSAS, COUNTY OF SEDGWICK, ss.
Wilson Rains (employee of owner) or (owner or operator) of the above-described well, being first duly sworn on oath, says: That I have knowledge of the facts, statements, and matters herein contained and the log of the above-described well as filed and that the same are true and correct. So help me God.

(Signature) Wilson Rains Wilson Rains
as above

SUBSCRIBED AND SWORN TO before me this 25 day of September 19 68

My commission expires 6-30-71 Sherry Gish Notary Public.