

Give All Information Completely  
Make Required Affidavit  
Mail or Deliver Report to:  
Conservation Division  
State Corporation Commission  
211 No. Broadway  
Wichita, Kansas

Thomas County, Sec. 34 Twp. 6S Rge. (E) 31 (W)

Location as "NE/CNW%SW%" or footage from lines C SE/4 SW/4

Lease Owner Target Drilling Corporation

Lease Name Preston Well No. 1

Office Address 910 Enterprise Building, Tulsa 3, Oklahoma

Character of Well (completed as Oil, Gas or Dry Hole) Dry hole

Date well completed 4-14 19 61

Application for plugging filed 4-11 19 61

Application for plugging approved 4-14 19 61


Plugging commenced 4-14 19 61

Plugging completed 4-14 19 61

Reason for abandonment of well or producing formation No productive horizons encountered

If a producing well is abandoned, date of last production 19

Was permission obtained from the Conservation Division or its agents before plugging was commenced? Yes

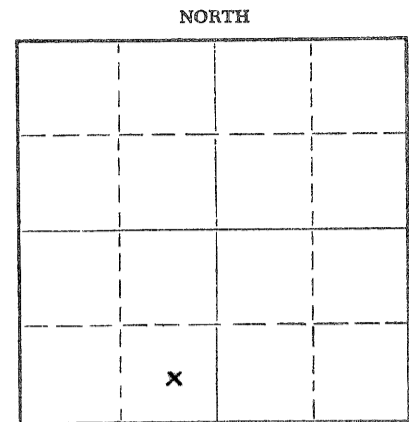

Locate well correctly on above Section Plat

Name of Conservation Agent who supervised plugging of this well Mr. Faricius, Hill City, Kansas

Producing formation None Depth to top x Bottom x Total Depth of Well 4647 Feet

Show depth and thickness of all water, oil and gas formations.

OIL, GAS OR WATER RECORDS

CASING RECORD

FORMATION	CONTENT	FROM	TO	SIZE	PUT IN	PULLED OUT
Water Sand	Fresh water	170'	180'	8 5/8"	228'	None

Describe in detail the manner in which the well was plugged, indicating where the mud fluid was placed and the method or methods used in introducing it into the hole. If cement or other plugs were used, state the character of same and depth placed, from \_\_\_\_\_ feet to \_\_\_\_\_ feet for each plug set.

Set cement plug at 420' with twenty sacks of cement, filled hole with mud to 200' and set cement plug with twenty sacks of cement, filled hole with mud to twenty feet from surface, set plug with ten sacks of cement with two wires attached to plug and extending to surface.

RECEIVED  
STATE CORPORATION COMMISSION

APR 20 1961

CONSERVATION DIVISION  
Wichita, Kansas

4-20-61

(If additional description is necessary, use BACK of this sheet)

Name of Plugging Contractor Halliburton Company  
Address Atwood, Kansas

STATE OF Oklahoma, COUNTY OF Tulsa, ss.

J. W. Garner (employee of owner) or (owner or operator) of the above-described well, being first duly sworn on oath, says: That I have knowledge of the facts, statements, and matters herein contained and the log of the above-described well as filed and that the same are true and correct. So help me God.

(Signature) J. W. Garner  
910 Enterprise Building Tulsa 3, Okla.  
(Address)

SUBSCRIBED AND SWORN TO before me this 19th day of April, 1961

Sylela Lockhart  
Notary Public.

My commission expires 10-15-63



DRILLERS SAMPLE DESCRIPTION

250-1255	Shale
1255-2050	Shale, sand and lime
2050-2244	Shale and lime shells
2244-2617	No description
2617-2795	Lime and shale
2795-3039	Red beds
3039-3200	Red beds and lime
3200-3339	Shale
3339-3440	Red beds and lime
3440-3499	No description
3499-3626	No description
3626-3810	Lime and shale
3810-3970	Lime
3970-4063	Lime and shale
4063-4282	Lime
4282-4345	No description
4345-4508	Lime
4508-4597	Lime and shale
4597-4621	Lime, shale, chert
4621-4646	Lime
4646-4647	Chert

T.D. 4647

  
C. S. Canman

State of Oklahoma )  
County of Tulsa )

Subscribed and sworn to me a Notary Public this 12  
day of April, 1961.

  
Notary Public

My Commission expires November 13, 1963.

RECEIVED  
STATE CORPORATION COMMISSION

APR 20 1961

CONSERVATION DIVISION  
Wichita, Kansas